MODIN M1030
AIR PURIFICATION

DCS CABINET Y1041
BOOSTER AIR SURPRESSOR

2	15-12-05	S.P.	AS BUILT	F.M.	-
1	26-07-05	S.P.	FOR CONSTRUCTION	F.M.	-
0	13-05-05	S.P.	FOR APPROVAL	F.M.	-
REV *REV*	DATE *DATE*	DESSINE PAR *DRAWN BY*	MODIFICATIONS *REVISIONS*	VERIFIE PAR *CHECKED BY*	APPROUVE PAR *APPROVED BY*

AFFAIRE / *JOB*

ZAPORO

ENSEMBLE / *PART*

INSTRUMENTATION

TITRE / *TITLE*

DCS CABINET Y1041

This document is AIR LIQUIDE's PROPERTY. 75 Quai d'ORSAY 75007 PARIS. It is STRICTLY CONFIDENTIAL. It cannot be REPRODUCED neither TRANSMITTED without AIR LIQUIDE's AUTHORIZATION.

43, rue de la Fontaine
Boîte Postale 25
77241 - Cesson cedex
téléphone : (33) 1.64.79.60.40
télécopie : (33) 1.60.63.57.49
E-mail : asm.cesson@wanadoo.fr

câblage électrique asm

AIR LIQUIDE INGENIERIE

ECHELLE *SCALE*	N° D'AFFAIRE *JOB NUMBER*	FMT *FMT*	GROUPE N° *GROUP NBR*
-	50-2852	A4	841-1041

2 1 0 Rev

A1/1312 - P7058-00.DWG - © A.S.M. - ATELIER SEINE ET MARNE

N° PAGE	INDICE 0	1	2	3	4	5	DOCUMENTS
0	X	X	X				Front page of the document
1	X	X	X				Table of contents
2	X	X					Table of contents
3	X						Front view
4	X		X				Inside arrangement of front view
5	X						Inside arrangement of rear view
6							Free
7	X	X					Interfaces modules arrangement – Rear view
8							Free
9							Free
10	X						Identification markers
11	X						Identification markers
12							Free
13							Free
14							Free
15							Free
16							Free
17							Free
18							Free
19	X						Power supply 230V~ – U.P.S. – Circuit diagram
20	X						Power supply 230V~ – U.P.S. – Circuit diagram
21	X						Power supply 230V~ U.P.S. – Terminal block X1
22							Free
23							Free
24							Free
25							Free
26							Free
27	X		X				Power supply 24V= – (PS01–PS02) – Circuit diagram

N° PAGE	INDICE 0	1	2	3	4	5	DOCUMENTS
28							Free
29	X						Power supply 24V=/230V~ Interfaces – Circuit diagram
30	X						Electric diagram fault circuit US 9041
31	X	X					Arrangement modules Rack
32							Free
33							Free
34							Free
35	X						Rack ANR01–04 – Slot 1 – AAI835 – 4AI/4AO–MIL–R–SW
36	X						Rack ANR01–04 – Slot 2 – AAI135 – 8AI–MIL–R–SW
37	X						Rack ANR01–04 – Slot 3 – AAI135 – 8AI–MIL–R–SW
38	X						Rack ANR01–04 – Slot 4 – AAI135 – 8AI–MIL–R–SW
39	X						Rack ANR01–04 – Slot 5 – AAR145 – 16RTD–KS–R
40	X						Rack ANR01–04 – Slot 5 – AAR145 – 16RTD–KS–R
41	X						Rack ANR01–04 – Slot 6 – AAR145 – 16RTD–KS–R
42	X						Rack ANR01–04 – Slot 6 – AAR145 – 16RTD–KS–R
43	X						Rack ANR01–04 – Slot 7 – ADV151 – 32DI–MIL–R
44	X						Rack ANR01–04 – Slot 7 – ADV151 – 32DI–MIL–R
45	X						Rack ANR01–04 – Slot 8 – ADV551 – 32DO–MIL–R
46	X						Rack ANR01–04 – Slot 8 – ADV551 – 32DO–MIL–R
47	X						Rack ANR01–04 – Slot 8 – ADV551 – 32DO–MIL–R
48	X						Rack ANR01–04 – Slot 8 – ADV551 – 32DO–MIL–R
49							Free
50							Free
51							Free
52							Free
53							Free
54							Free
55							Free

câblage électrique asm

AIR LIQUIDE INGENIERIE

JOB Number Designation: 50–2852 ZAPORO

DOCUMENT NUMBER: 841–1041

BOOSTER AIR SURPRESSOR

MODIN M1030
DCS CABINET Y1041
Table of contents

index	0	1	2			PAGE
date	13–05–05	26–07–05	15–12–05			1/99
name	S.P.	S.P.	S.P.			
sign	F.M.	F.M.	F.M.			

A1/1312 – P7058–01.DWG – © A.S.M. – ATELIER SEINE ET MARNE – BP25–77241 CESSON CEDEX–TEL:(33) 1.64.79.60.40–FAX:(33) 1.60.63.57.49

N° PAGE	INDICE 0	1	2	3	4	5	DOCUMENTS
56							Free
57							Free
58							Free
59							Free
60							Free
61							Free
62							Free
63							Free
64							Free
65							Free
66							Free
67							Free
68							Free
69							Free
70							Free
71							Free
72							Free
73							Free
74							Free
75							Free
76							Free
77							Free
78							Free
79							Free
80							Free
81	X						Terminals blocks – MTB1041A
82	X						Terminals blocks – LTB1041A
83	X						Terminals blocks – STB1041A

N° PAGE	INDICE 0	1	2	3	4	5	DOCUMENTS
84							Free
85	X	X					Level Switch Mobrey – LSH *
86							Free
87							Free
88							Free
89							Free
90							Free
91							Free
92							Free
93							Free
94							Free
95	X						Equipments list
96							Free
97	X						Equipments list
98							Free
99	X						Equipments list
100							
101							
câblage électrique asm

AIR LIQUIDE INGENIERIE

JOB Number Designation: 50–2852 ZAPORO

DOCUMENT NUMBER: 841–1041

BOOSTER AIR SURPRESSOR


MODIN M1030
DCS CABINET Y1041
Table of contents

index	0	1				PAGE
date	13–05–05	26–07–05				2/99
name	S.P.	S.P.				
sign	F.M.	F.M.				

A1/1312 – P7058–02.DWG – © A.S.M. – ATELIER SEINE ET MARNE – BP25–77241 CESSON CEDEX–TEL:(33) 1.64.79.60.40–FAX:(33) 1.60.63.57.49

1	2	3	4	5	6	7	8	9

FRONT VIEW

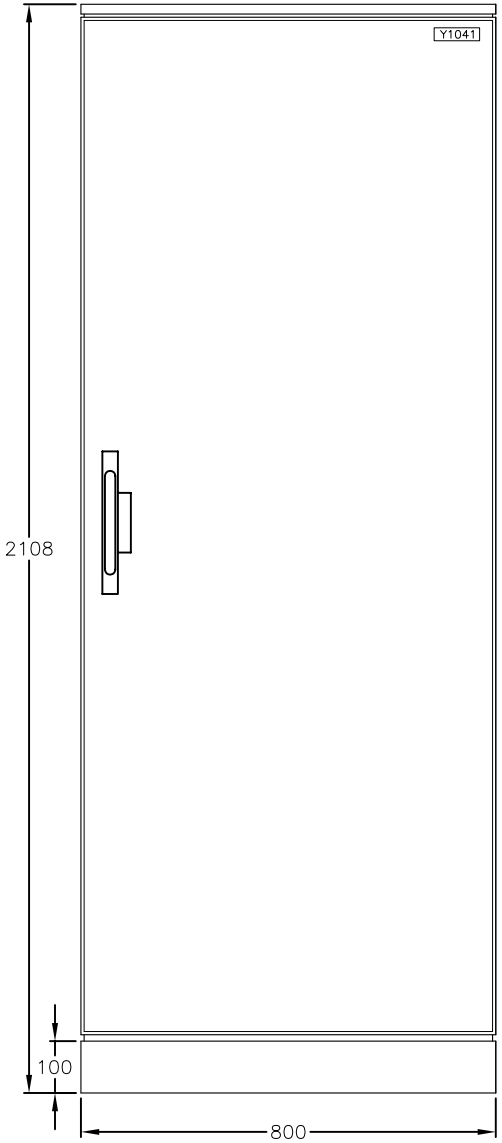


câblage électrique asm AIR LIQUIDE INGENIERIE	JOB Number 50-2852 Designation ZAPORO	DOCUMENT NUMBER 841-1041	MODIN M1030 DCS CABINET Y1041 Front view	index	0		PAGE
	BOOSTER AIR SURPRESSOR			date	13-05-05		3/99
				name	S.P.		
				sign	F.M.		

A1/1312 - P7058-03.DWG - © A.S.M. - ATELIER SEINE ET MARNE - BP25-77241 CESSON CEDEX-TEL:(33) 1.64.79.60.40-FAX:(33) 1.60.63.57.49

1	2	3	4	5	6	7	8	9

INSIDE ARRANGEMENT OF FRONT VIEW

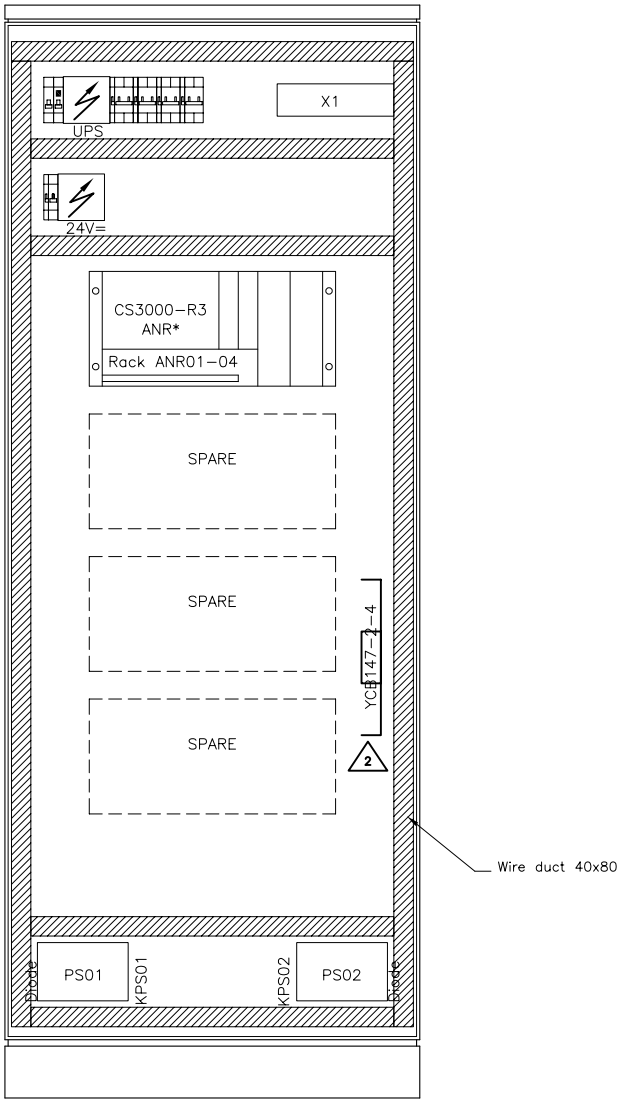

câblage électrique asm

AIR LIQUIDE INGENIERIE


JOB Number	50-2852	DOCUMENT NUMBER	MODIN M1030
Designation	ZAPORO	841-1041	DCS CABINET Y1041
BOOSTER AIR SURPRESSOR			Inside arrangement of front view

index	0	2				PAGE
date	13-05-05	15-12-05				4 / 99
name	S.P.	S.P.				
sign	F.M.	F.M.				

A1/1312 - P7058-04.DWG - © A.S.M. - ATELIER SEINE ET MARNE - BP25-77241 CESSON CEDEX-TEL:(33) 1.64.79.60.40-FAX:(33) 1.60.63.57.49

1	2	3	4	5	6	7	8	9

INSIDE ARRANGEMENT OF REAR VIEW

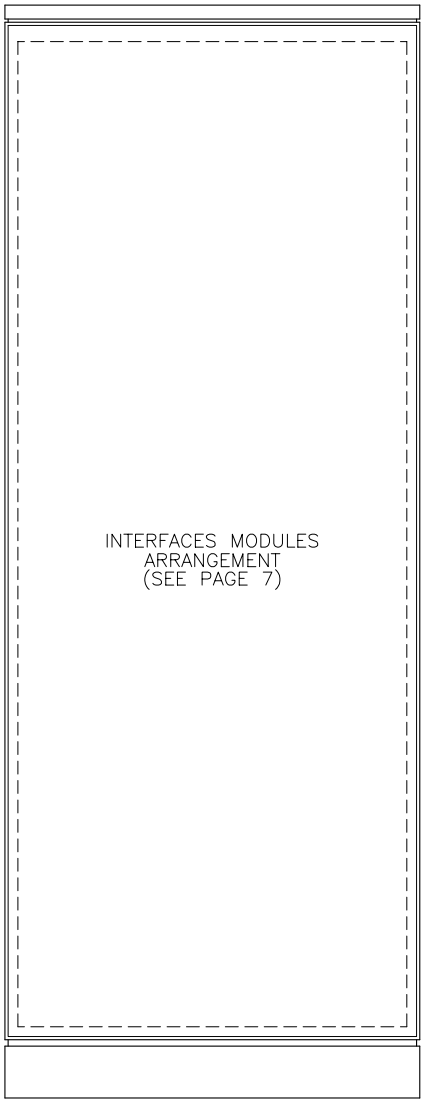


A1/1312 – P7058–05.DWG – © A.S.M. – ATELIER SEINE ET MARNE – BP25–77241 CESSON CEDEX–TEL:(33) 1.64.79.60.40–FAX:(33) 1.60.63.57.49

câblage électrique asm

AIR LIQUIDE INGENIERIE

JOB Number	50–2852	DOCUMENT NUMBER	MODIN M1030	index	0		PAGE
Designation	ZAPORO	841–1041	DCS CABINET Y1041	date	13–05–05		5 / 99
BOOSTER AIR SURPRESSOR			Inside arrangement of rear view	name	S.P.		
				sign	F.M.		

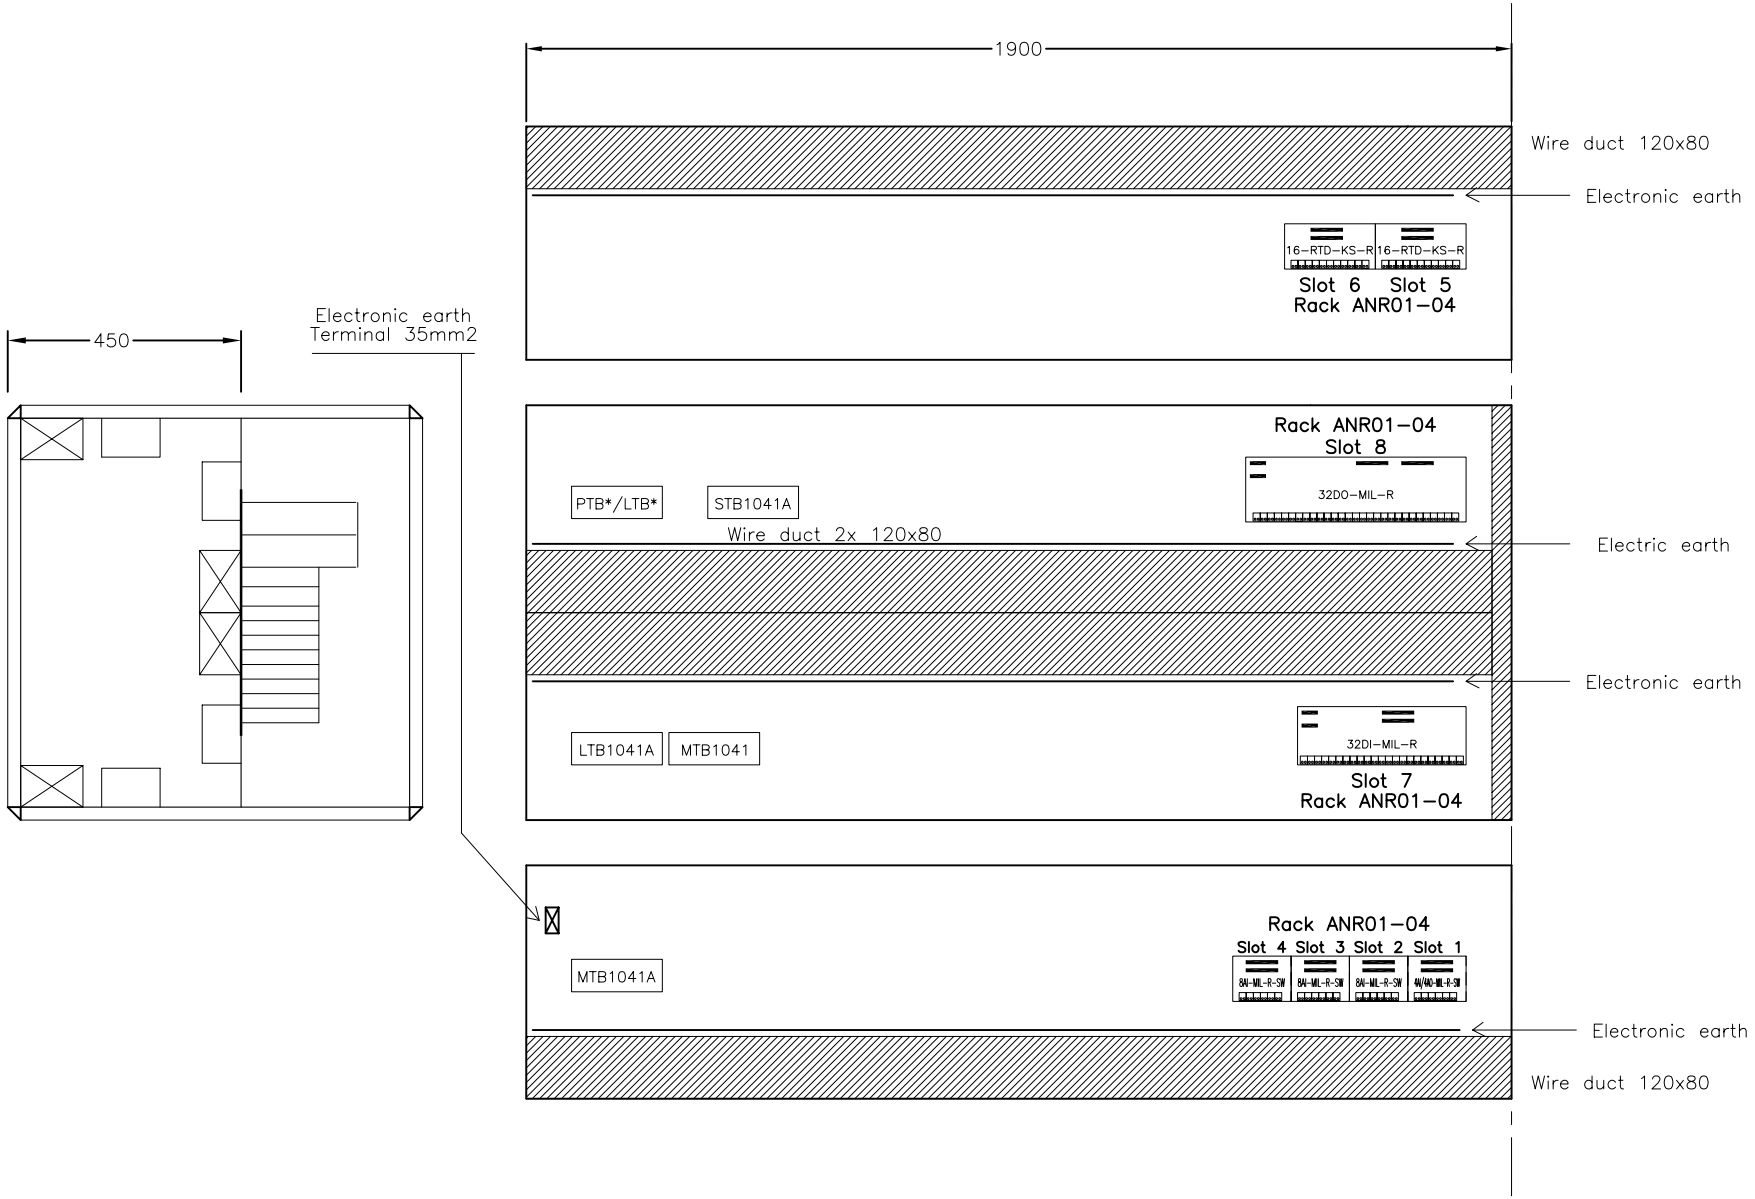

câblage électrique asm / AIR LIQUIDE INGENIERIE	JOB Number 50-2852 Designation ZAPORO	DOCUMENT NUMBER 841-1041	MODIN M1030 DCS CABINET Y1041 Interfaces modules arrangement Rear view	index	0	1	PAGE
	BOOSTER AIR SURPRESSOR			date	13-05-05	26-07-05	7/99
				name	S.P.	S.P.	
				sign	F.M.	F.M.	


A1/1312 - P7058-07.DWG - © A.S.M. - ATELIER SEINE ET MARNE - BP25-77241 CESSON CEDEX-TEL:(33) 1.64.79.60.40-FAX:(33) 1.60.63.57.49


Tag Number	NAME PLATES "LABEL"			Qty	DIMENSIONS	
	LINE N°1	LINE N°2	LINE N°3		A	B
1	Y1041			1	40	120
2	RACK ANR01-04			1	20	40
3						
4						
5						
6						
7	Q1 - GENERAL	CIRCUIT BREAKER	230V-50Hz - UPS	1	20	36
8	Q1.1 - 230V~ UPS	POWER SUPPLY	Terminal block X1	1	20	45
9	Q1.2 - 230V~ UPS	POWER SUPPLY	PS01 - 24V=	1	20	45
10	Q1.3 - 230V~ UPS	POWER SUPPLY	PS02 - 24V=	1	20	45
11	Q1.4 - 230V~ UPS	POWER SUPPLY	Interfaces - 230V~	1	20	45
12						
13						
14						
15						
16						
17						
18						
19						
20						
21						
22	PS01-POWER SUPPLY	24V=		1	20	120
22	PS02-POWER SUPPLY	24V=		1	20	120
24	KPS01			1	20	20
25	KPS02			1	20	20
26	Q24V - 24V=	POWER SUPPLY	Interfaces	1	20	36
27						
28						

Tag Number	NAME PLATES "LABEL"			Qty	DIMENSIONS	
	LINE N°1	LINE N°2	LINE N°3		A	B
29	X1 - 230V~			1	10	30
30						
31						
32						
33						
34						
35						
36						
37						
38						
39						
40						
41						
42	MTB1041A			1	20	40
43	LTB1041A			1	20	40
44	STB1041A			1	20	40
45	MTB1041			1	20	40
46	LTB1041			1	20	40
47	PTB1041	GENERAL INCOMING		1	20	40
48						

Material : White phenolic label 1.6 Thickness-Black lettering.

Fixing : By Glueing.

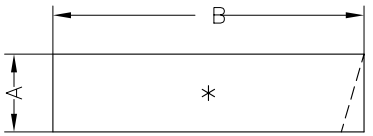

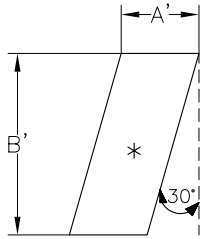

câblage électrique asm

AIR LIQUIDE INGENIERIE

JOB Number 50-2852
Designation ZAPORO

DOCUMENT NUMBER 841-1041

BOOSTER AIR SURPRESSOR

MODIN M1030
DCS CABINET Y1041
Identification markers

index	0					PAGE
date	13-05-05					10 / 99
name	S.P.					
sign	F.M.					


A1/1312 - P7058-10.DWG - © A.S.M. - ATELIER SEINE ET MARNE - BP25-77241 CESSON CEDEX-TEL:(33) 1.64.79.60.40-FAX:(33) 1.60.63.57.49


Tag Number	NAME PLATES "LABEL"			Qty	DIMENSIONS	
	LINE N°1	LINE N°2	LINE N°3		A	B
49	RACK ANR01-04/S01			1	10	30
50	RACK ANR01-04/S02			1	10	30
51	RACK ANR01-04/S03			1	10	30
52	RACK ANR01-04/S04			1	10	30
53	RACK ANR01-04/S05			1	10	30
54	RACK ANR01-04/S06			1	10	30
55	RACK ANR01-04/S07			1	10	30
56	RACK ANR01-04/S08			1	10	30
57						
58						
Tag Number	NAME PLATES "LABEL"			Qty	DIMENSIONS	
	LINE N°1	LINE N°2	LINE N°3		A	B
77						
78						
Material : White phenolic label 1.6 Thickness–Black lettering.

Fixing : By Glueing.

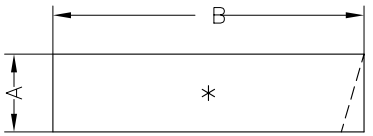

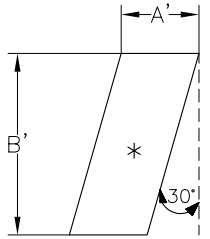

A1/1312 – P7058–11.DWG – © A.S.M. – ATELIER SEINE ET MARNE – BP25–77241 CESSON CEDEX–TEL.:(33) 1.64.79.60.40–FAX:(33) 1.60.63.57.49

câblage électrique asm

AIR LIQUIDE INGENIERIE


JOB Number 50–2852
Designation ZAPORO

DOCUMENT NUMBER 841–1041

BOOSTER AIR SURPRESSOR

MODIN M1030
DCS CABINET Y1041
Identification markers


index	0					PAGE
date	13–05–05					11 / 99
name	S.P.					
sign	F.M.					

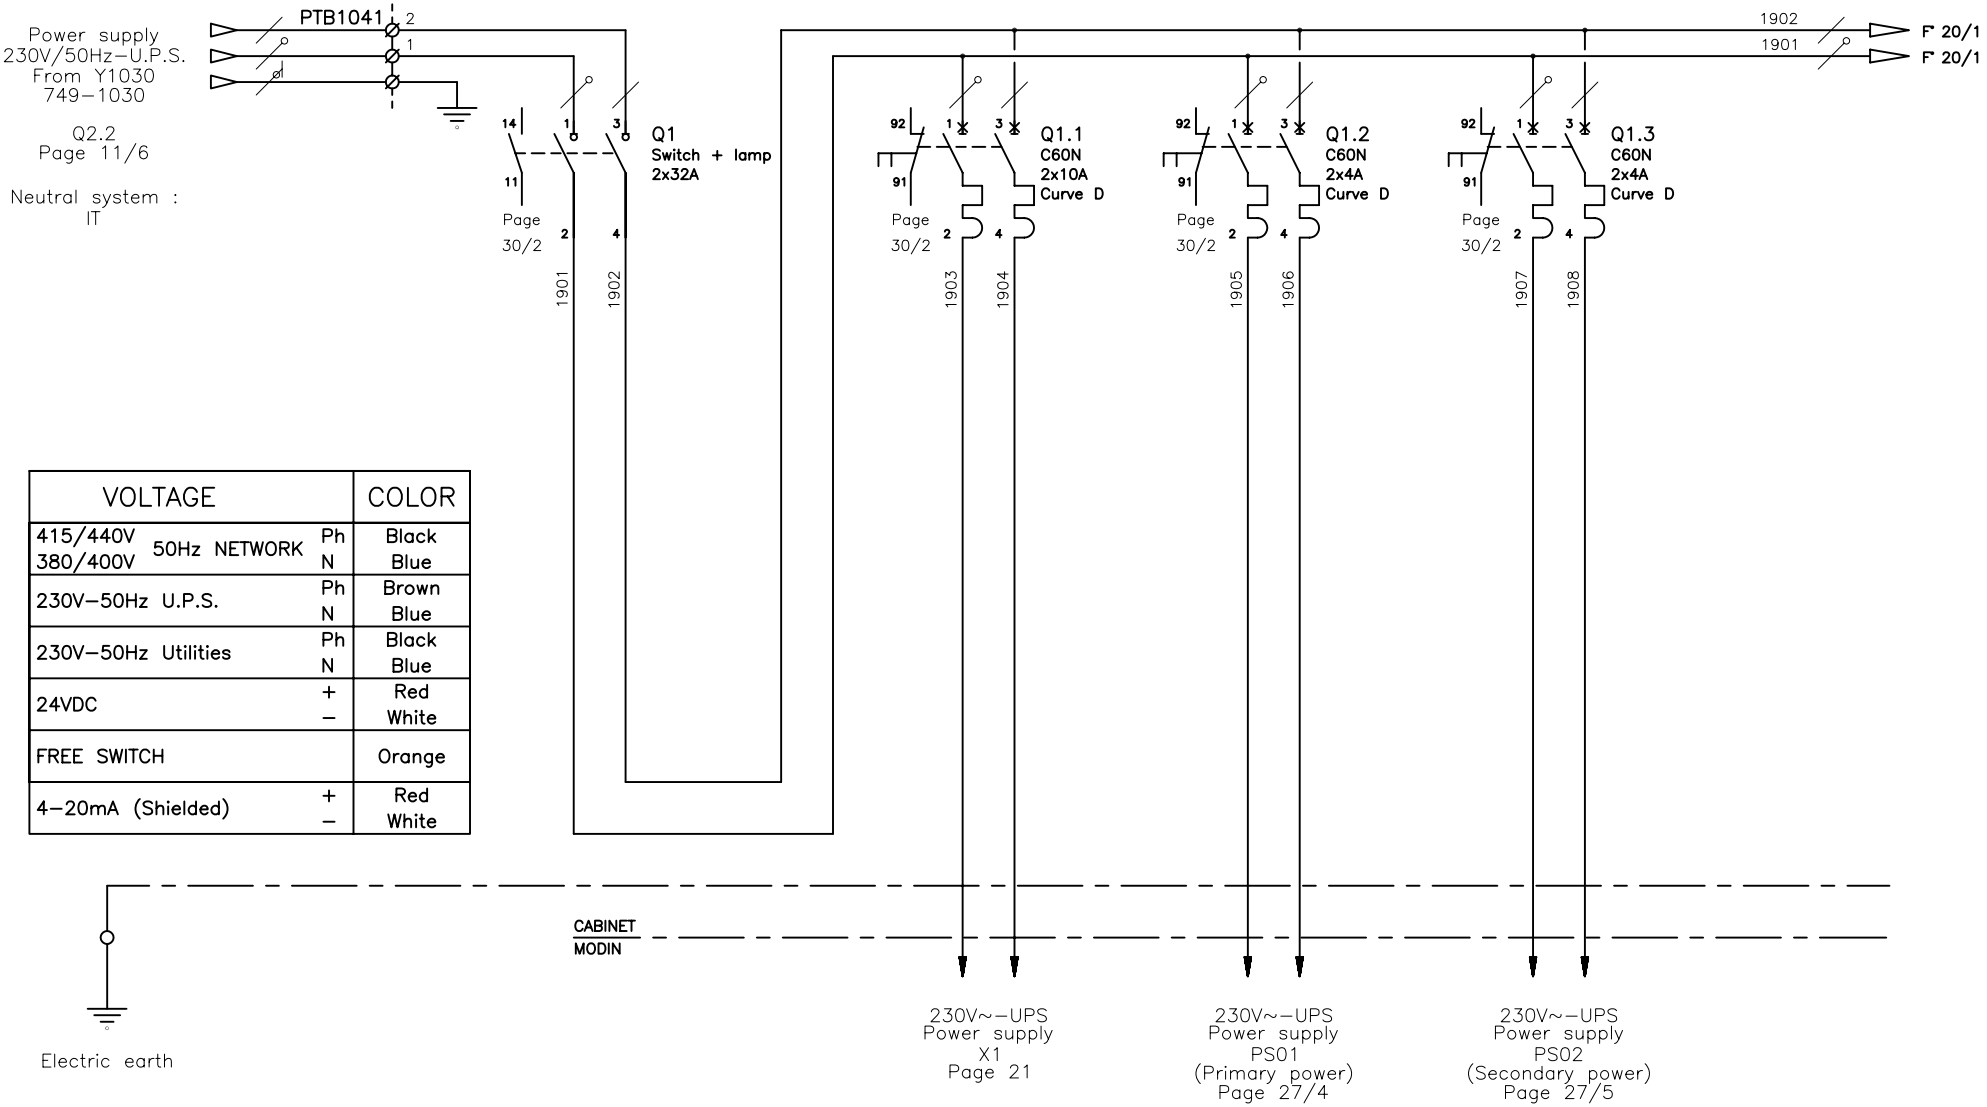

VOLTAGE		COLOR
415/440V 380/400V 50Hz NETWORK	Ph	Black
	N	Blue
230V–50Hz U.P.S.	Ph	Brown
	N	Blue
230V–50Hz Utilities	Ph	Black
	N	Blue
24VDC	+	Red
	–	White
FREE SWITCH		Orange
4–20mA (Shielded)	+	Red
	–	White


câblage électrique asm	JOB Number Designation 50–2852 ZAPORO	DOCUMENT NUMBER 841–1041	MODIN M1030 DCS CABINET Y1041 Power supply 230V~ – U.P.S. Circuit diagram	index	0		PAGE
AIR LIQUIDE INGENIERIE	BOOSTER AIR SURPRESSOR			date	13–05–05		19/99
				name	S.P.		
				sign	F.M.		

A1/1312 – P7058–19.DWG – © A.S.M. – ATELIER SEINE ET MARNE – BP25–77241 CESSON CEDEX–TEL.:(33) 1.64.79.60.40–FAX:(33) 1.60.63.57.49

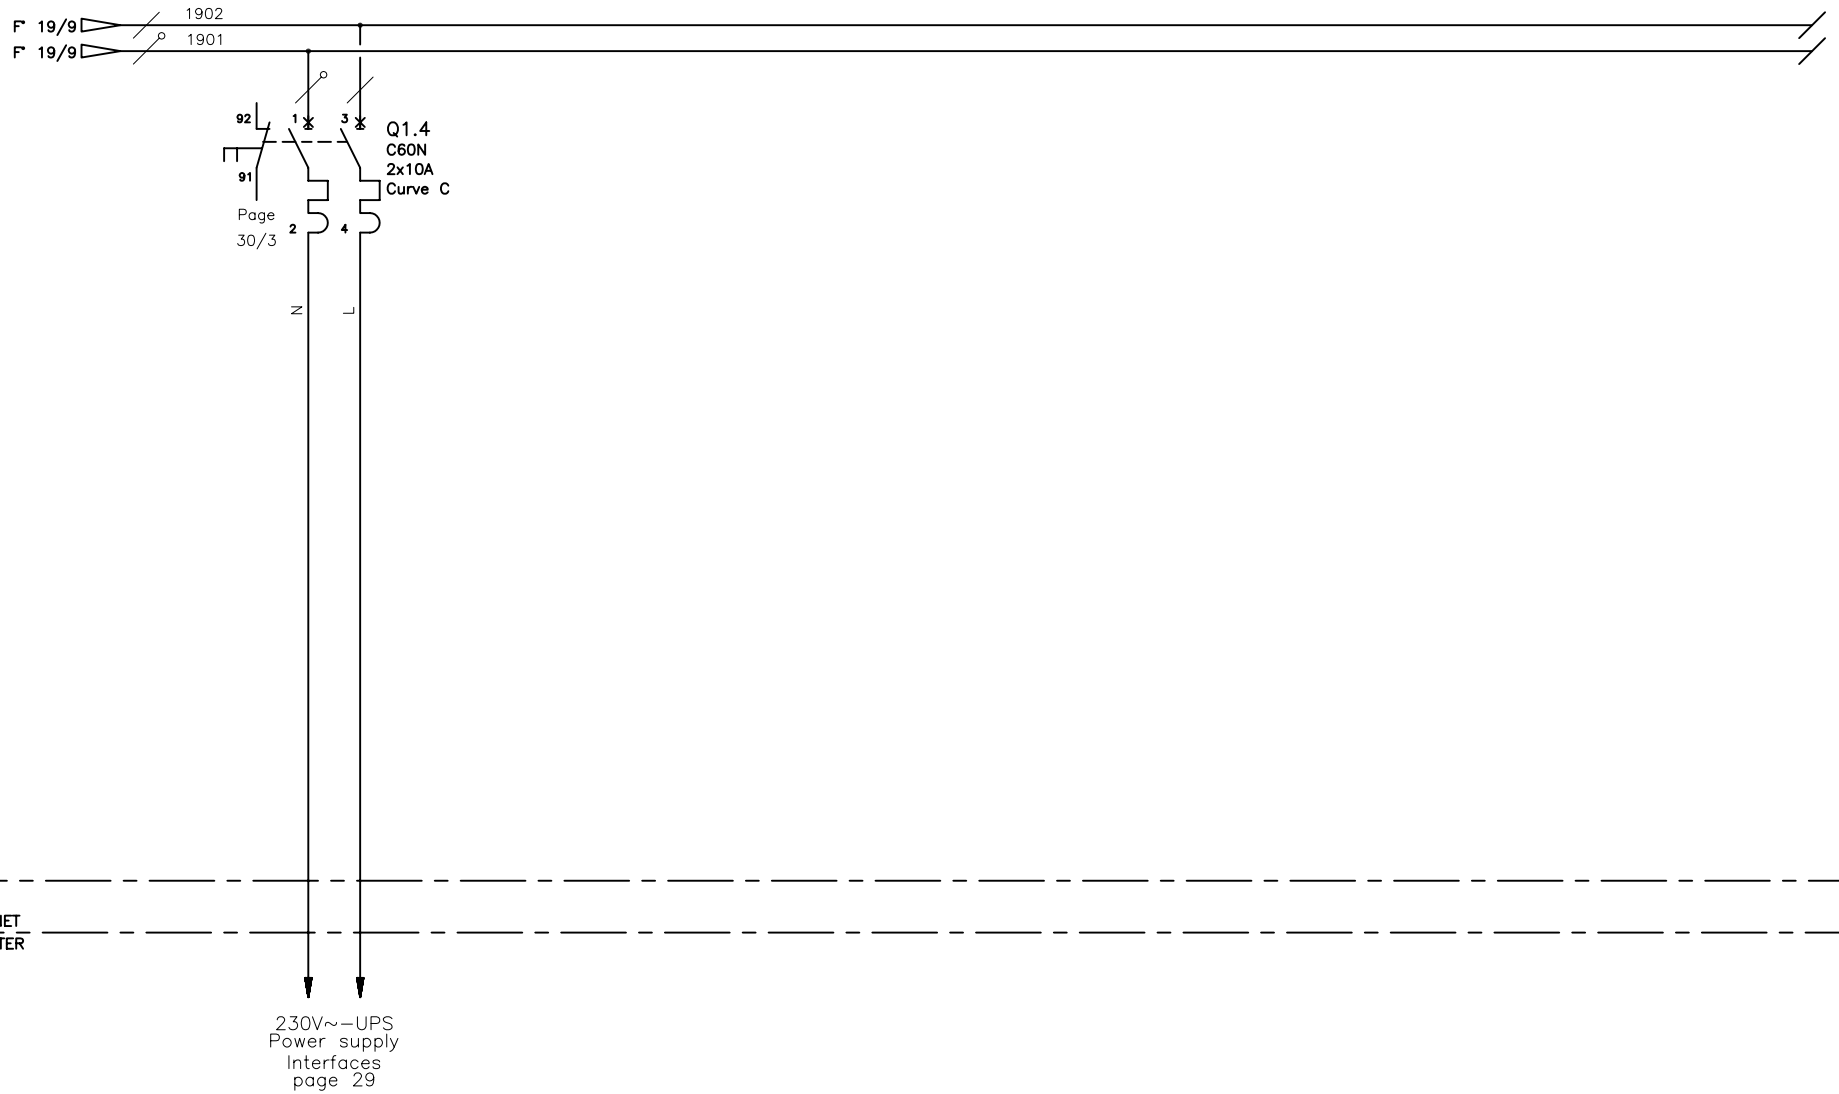

câblage électrique asm	JOB Number 50-2852	DOCUMENT NUMBER	MODIN M1030	index	0					PAGE
	Designation ZAPORO	841-1041	DCS CABINET Y1041	date	13-05-05					20/99
AIR LIQUIDE INGENIERIE	BOOSTER AIR SURPRESSOR		Power supply 230V~ - U.P.S. Circuit diagram	name	S.P.					
				sign	F.M.					


A1/1312 - P7058-20.DWG - © A.S.M. - ATELIER SEINE ET MARNE - BP25-77241 CESSON CEDEX-TEL:(33) 1.64.79.60.40-FAX:(33) 1.60.63.57.49

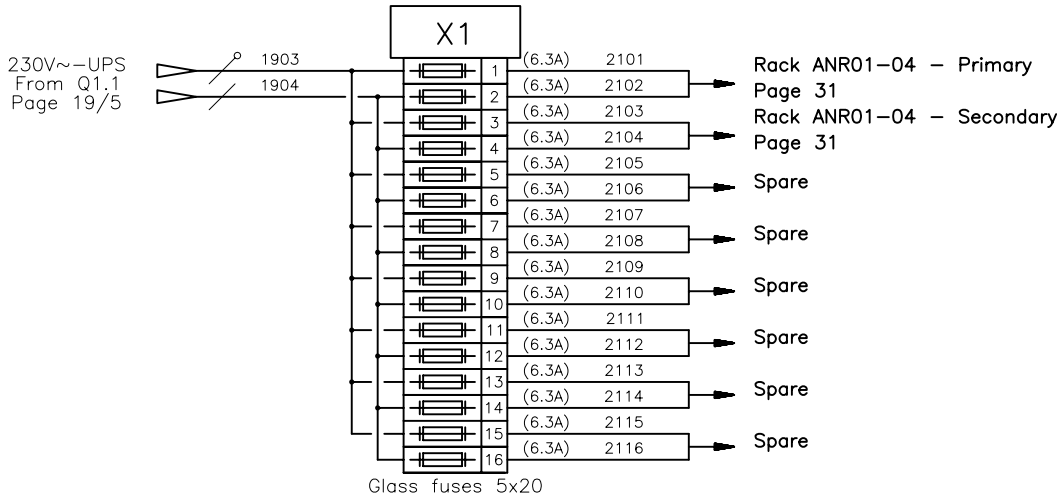

Glass fuse


câblage électrique asm / AIR LIQUIDE INGENIERIE	JOB Number 50-2852 Designation ZAPORO	DOCUMENT NUMBER 841-1041	MODIN M1030 DCS CABINET Y1041 Power supply 230V~ - U.P.S. Terminal block X1	index	0					PAGE 21/99
	BOOSTER AIR SURPRESSOR			date	13-05-05					
				name	S.P.					
				sign	F.M.					

A1/1312 - P7058-21.DWG - © A.S.M. - ATELIER SEINE ET MARNE - BP25-77241 CESSON CEDEX-TEL:(33) 1.64.79.60.40-FAX:(33) 1.60.63.57.49

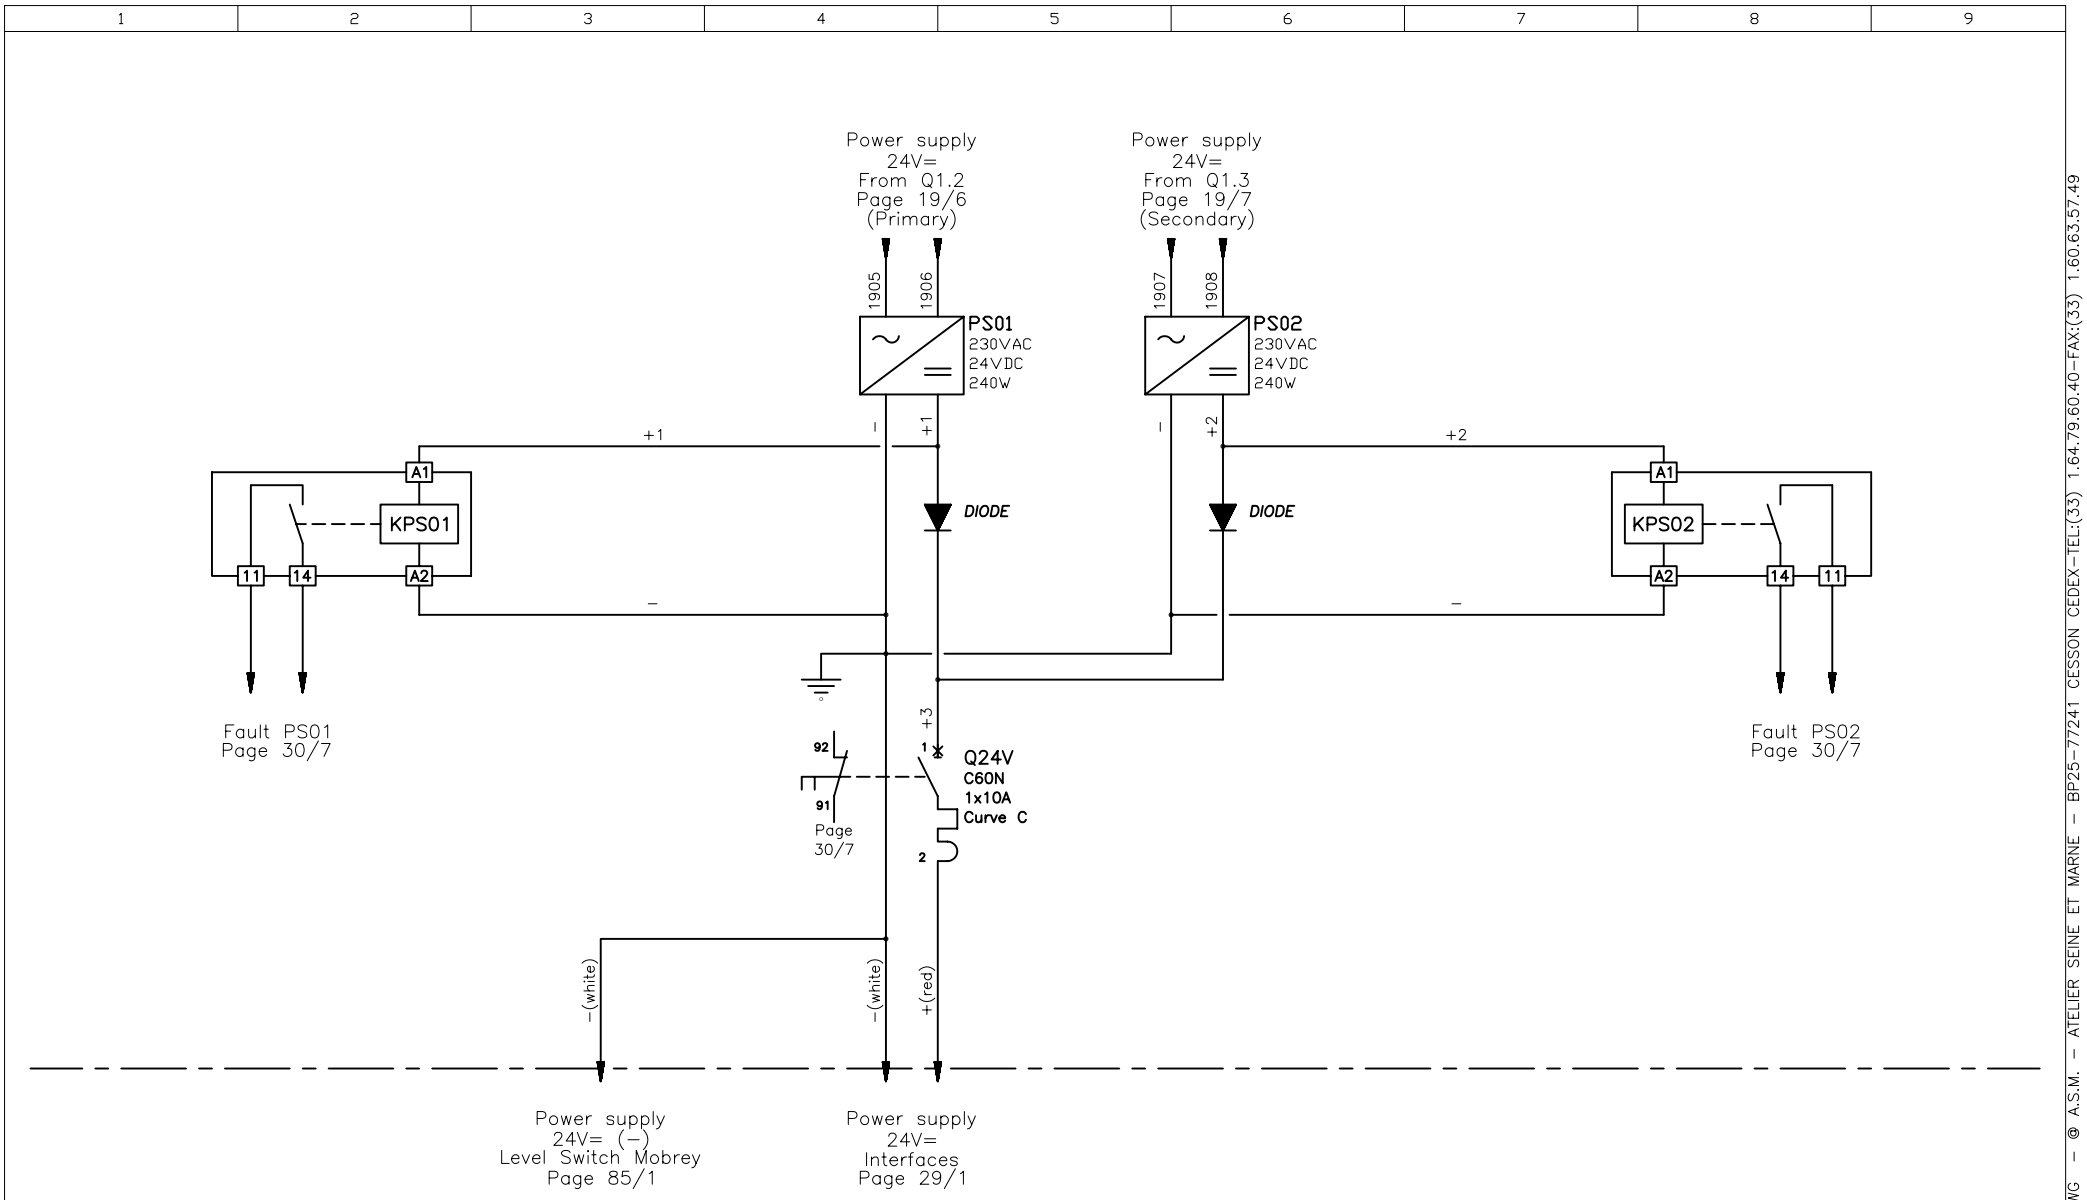


câblage électrique asm	JOB Number 50-2852	DOCUMENT NUMBER	MODIN M1030 DCS CABINET Y1041 Power supply 24V= (PS01-PS02) Circuit diagram	index	0					PAGE
AIR LIQUIDE INGENIERIE	Designation ZAPORO	841-1041		date	13-05-05					27/99
	BOOSTER AIR SURPRESSOR			name	S.P.					
				sign	F.M.					

A1/1312 - P7058-27.DWG - © A.S.M. - ATELIER SEINE ET MARNE - BP25-77241 CESSON CEDEX-TEL:(33) 1.64.79.60.40-FAX:(33) 1.60.63.57.49

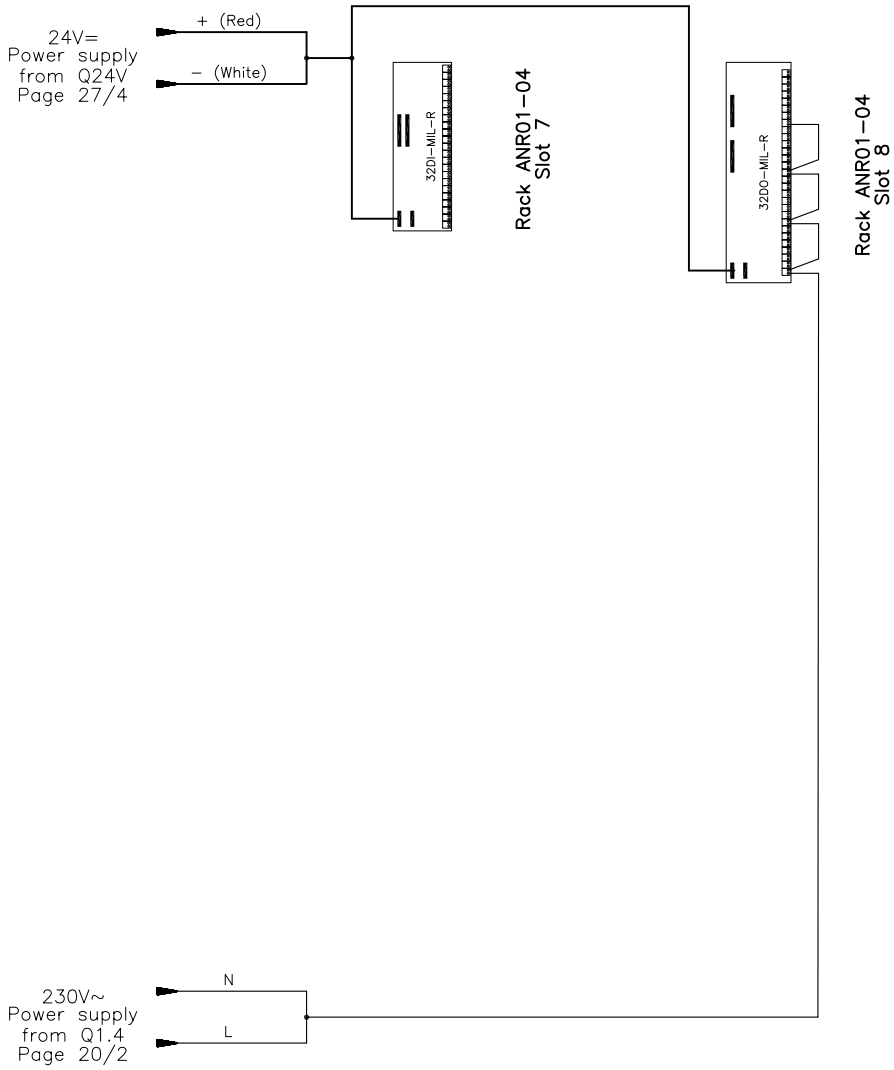


câblage électrique asm AIR LIQUIDE INGENIERIE	JOB Number 50–2852 Designation ZAPORO	DOCUMENT NUMBER 841–1041	MODIN M1030 DCS CABINET Y1041 Power supply 24V=/230V~ Interfaces Circuit diagram	index	0					PAGE
	BOOSTER AIR SURPRESSOR			date	13–05–05					29/99
				name	S.P.					
				sign	F.M.					

A1/1312 – P7058–29.DWG – © A.S.M. – ATELIER SEINE ET MARNE – BP25–77241 CESSON CEDEX–TEL:(33) 1.64.79.60.40–FAX:(33) 1.60.63.57.49

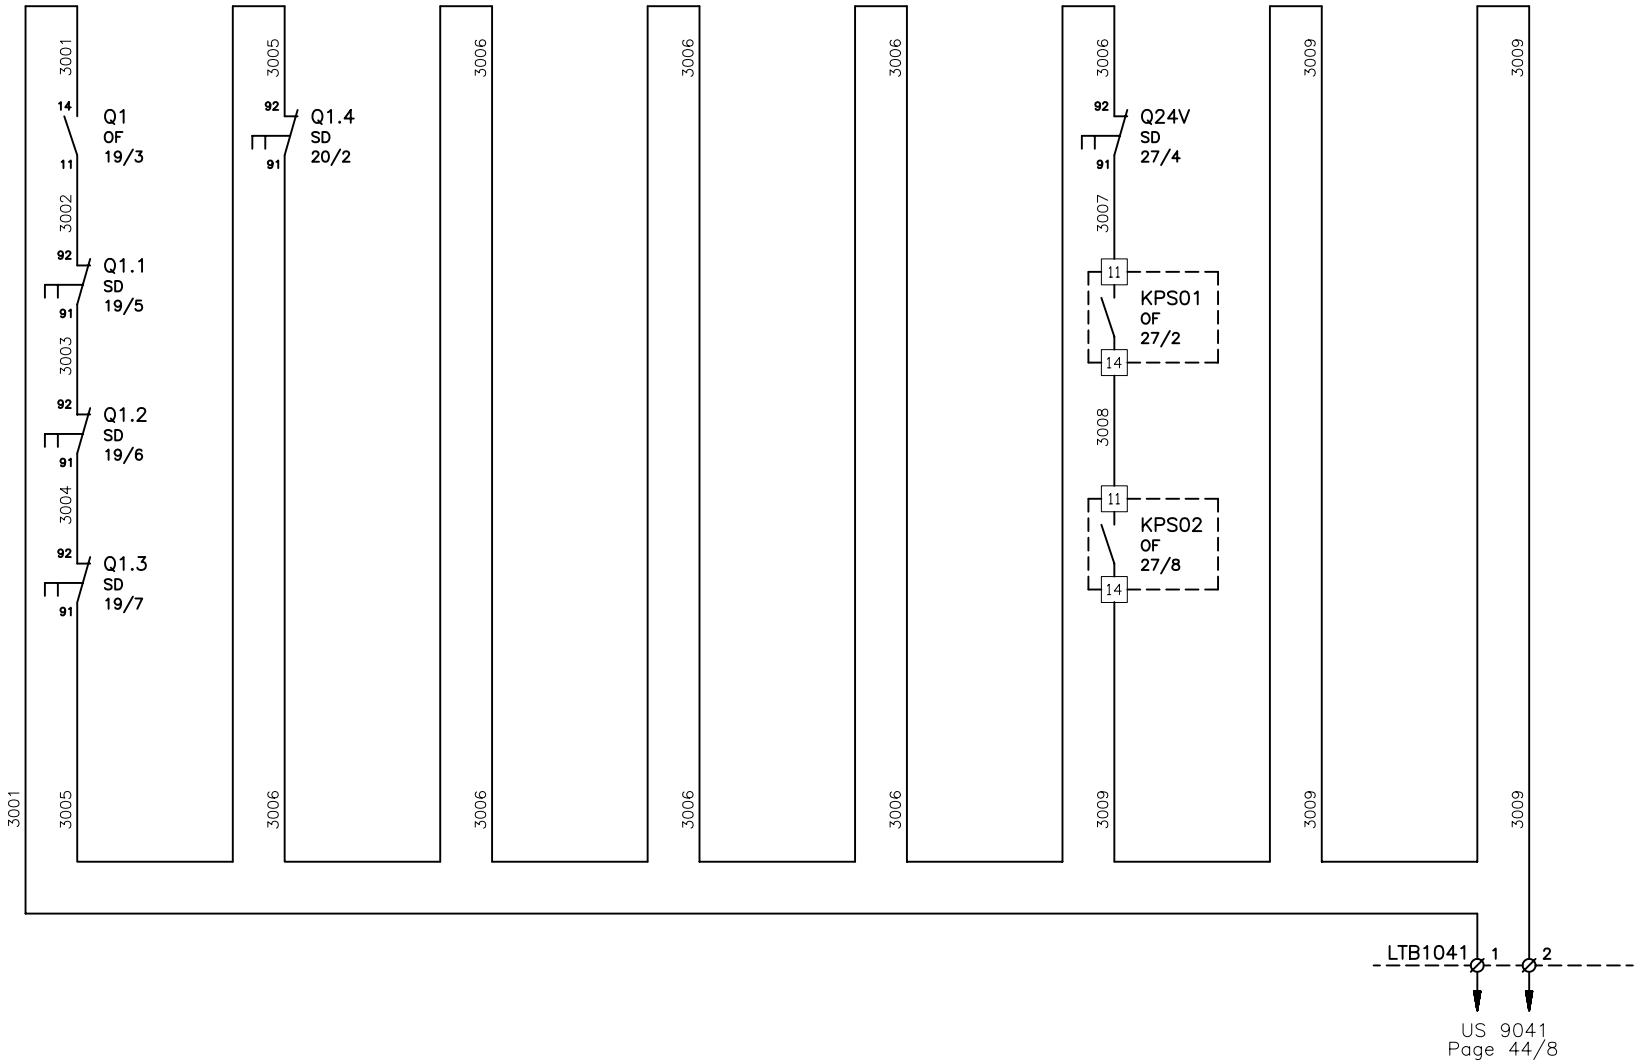

câblage électrique asm	JOB Number 50–2852	DOCUMENT NUMBER	MODIN M1030	index	0					PAGE
	Designation ZAPORO	841–1041	DCS CABINET Y1041	date	13–05–05					30 / 99
AIR LIQUIDE INGENIERIE	BOOSTER AIR SURPRESSOR		Electrical diagram fault	name	S.P.					
				sign	F.M.					

A1/1312 – P7058–30.DWG – © A.S.M. – ATELIER SEINE ET MARNE – BP25–77241 CESSON CEDEX–TEL:(33) 1.64.79.60.40–FAX:(33) 1.60.63.57.49

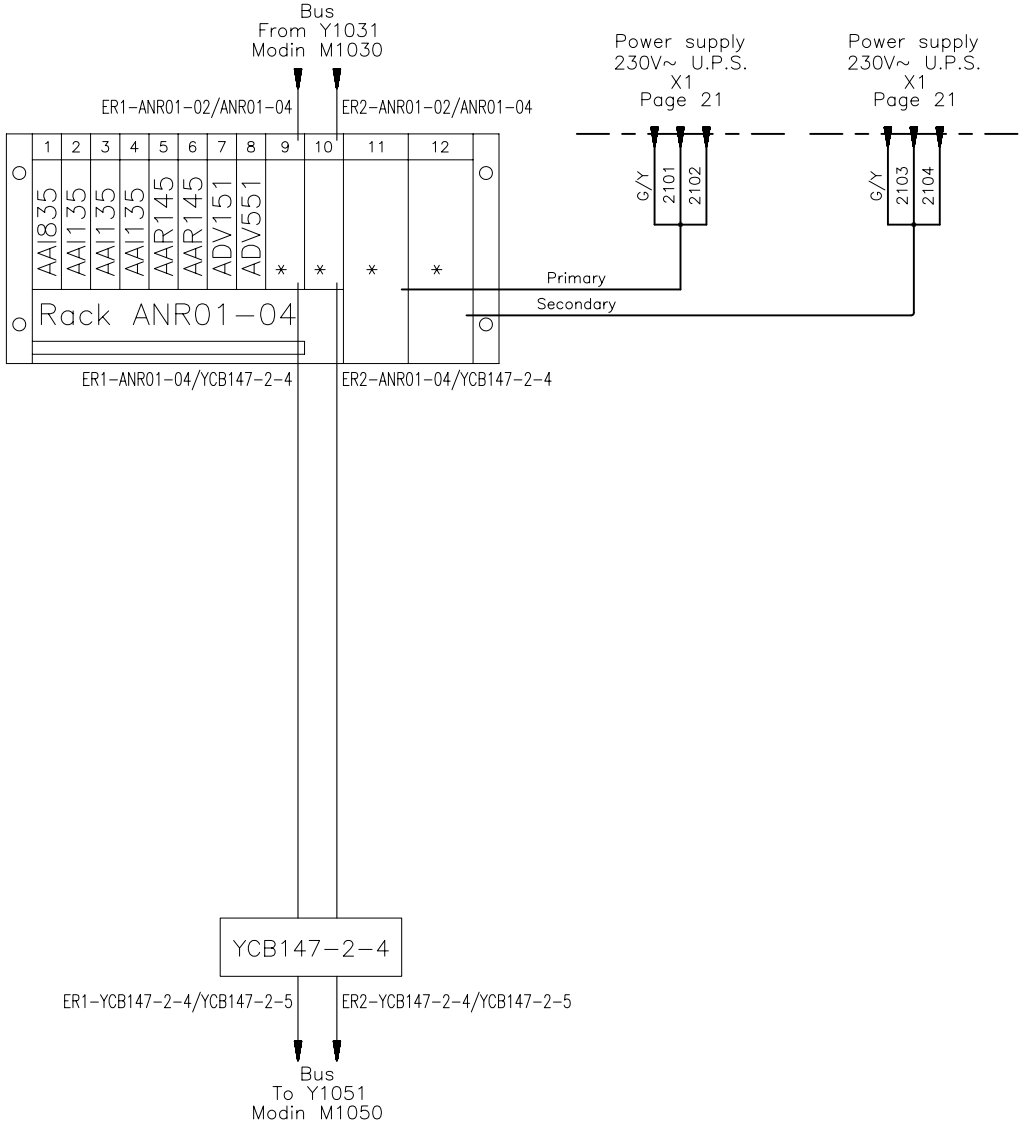

Card	Interface	Cable
YOKOGAWA – CS3000 AAI835	YOKOGAWA – Module 4AI/4AO 4AI/4AO-MIL-R-SW	WAGO – Cable 40pts 51023537
YOKOGAWA – CS3000 AAI135	YOKOGAWA – Module 8AI 8AI-MIL-R-SW	WAGO – Cable 40pts 51023537
YOKOGAWA – CS3000 AAR145	YOKOGAWA – Module 16RTD 16RTD-KS-R	WAGO – Cable 50pts 51023538
YOKOGAWA – CS3000 ADV551	YOKOGAWA – Module 32DO 32DO-MIL-R	WAGO – Cable 50pts 51023538
YOKOGAWA – CS3000 ADV151	YOKOGAWA – Module 32DI 32DI-MIL-R	WAGO – Cable 50pts 51023538

câblage électrique asm

AIR LIQUIDE INGENIERIE

JOB Number 50-2852
Designation ZAPORO

DOCUMENT NUMBER 841-1041

BOOSTER AIR SURPRESSOR

MODIN M1030
DCS CABINET Y1041
Arrangement modules Rack

index	0	1				PAGE
date	13-05-05	26-07-05				31/99
name	S.P.	S.P.				
sign	F.M.	F.M.				

A1/1312 – P7058-31.DWG – © A.S.M. – ATELIER SEINE ET MARNE – BP25-77241 CESSON CEDEX-TEL:(33) 1.64.79.60.40-FAX:(33) 1.60.63.57.49


1	2	3	4	5	6	7	8	9

Switching Configuration

3 1 2	Analog input internal power
3 1 2	Analog input external power or Analog output

- YOKOGAWA -

Interface 4AI/AO−MIL−R−SW
Rack ANR01−04 − Slot 1

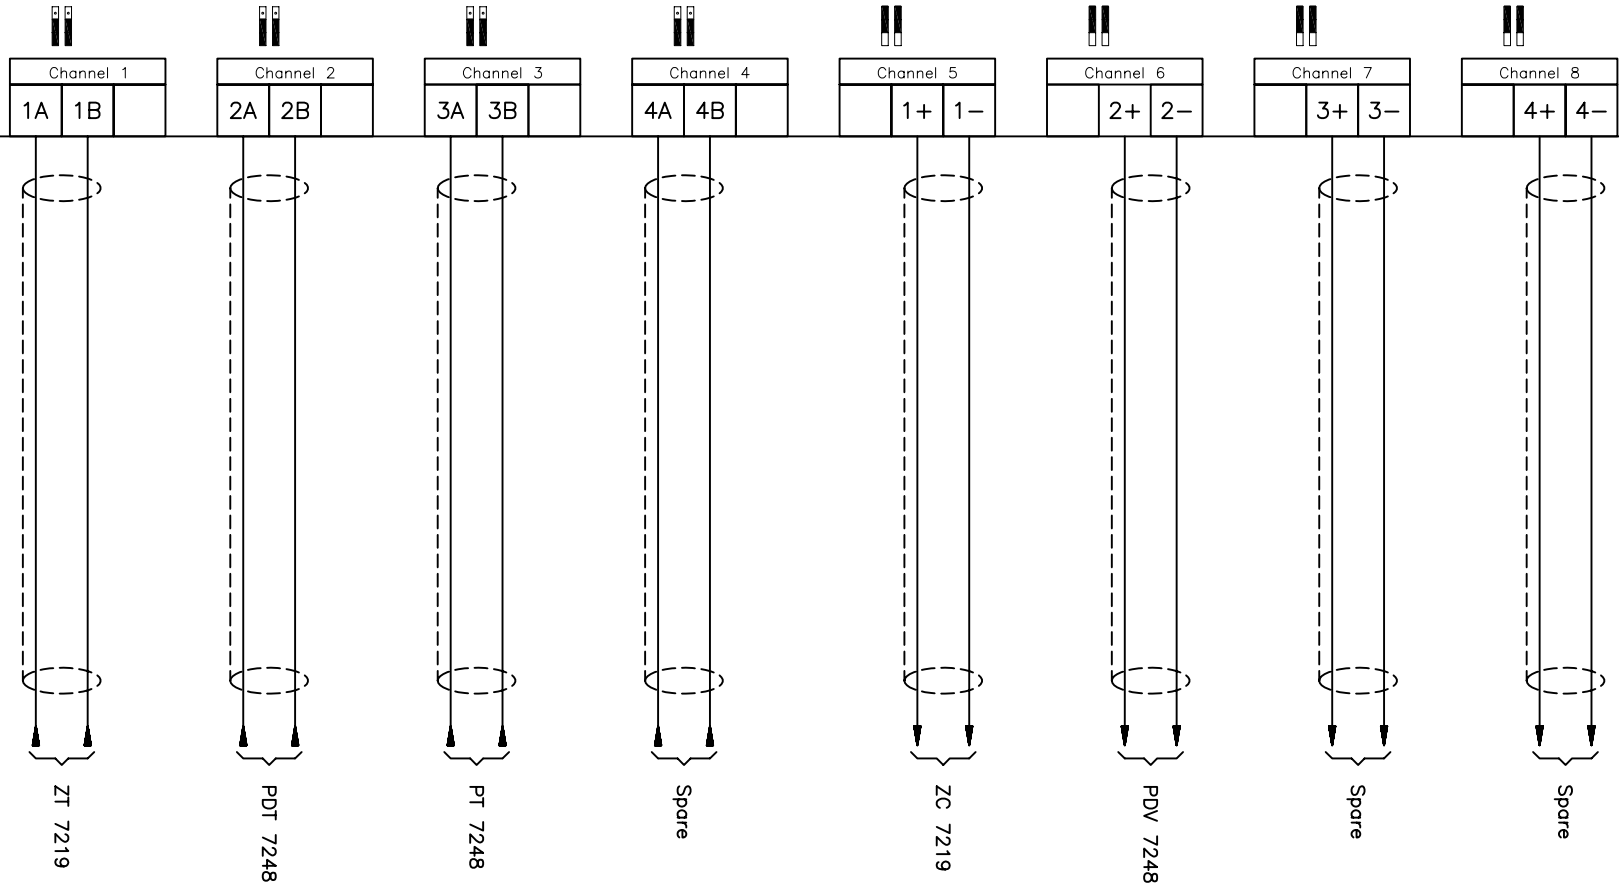

câblage électrique asm / AIR LIQUIDE INGENIERIE	JOB Number 50−2852 Designation ZAPORO	DOCUMENT NUMBER 841−1041	MODIN M1030 DCS CABINET Y1041 Terminals diagram Rack ANR01−04 − Slot 1 AAI835 − 4AI/4AO−MIL−R−SW	index	0					PAGE 35/99
	BOOSTER AIR SURPRESSOR			date	13−05−05					
				name	S.P.					
				sign	F.M.					


A1/1312 − P7058−35.DWG − © A.S.M. − ATELIER SEINE ET MARNE − BP25−77241 CESSON CEDEX−TEL:(33) 1.64.79.60.40−FAX:(33) 1.60.63.57.49

1	2	3	4	5	6	7	8	9

Switching Configuration	
3 1 2	Analog input internal power
3 1 2	Analog input external power or Analog output

- YOKOGAWA -

Interface 8AI–MIL–R–SW
Rack ANR01–04 – Slot 2

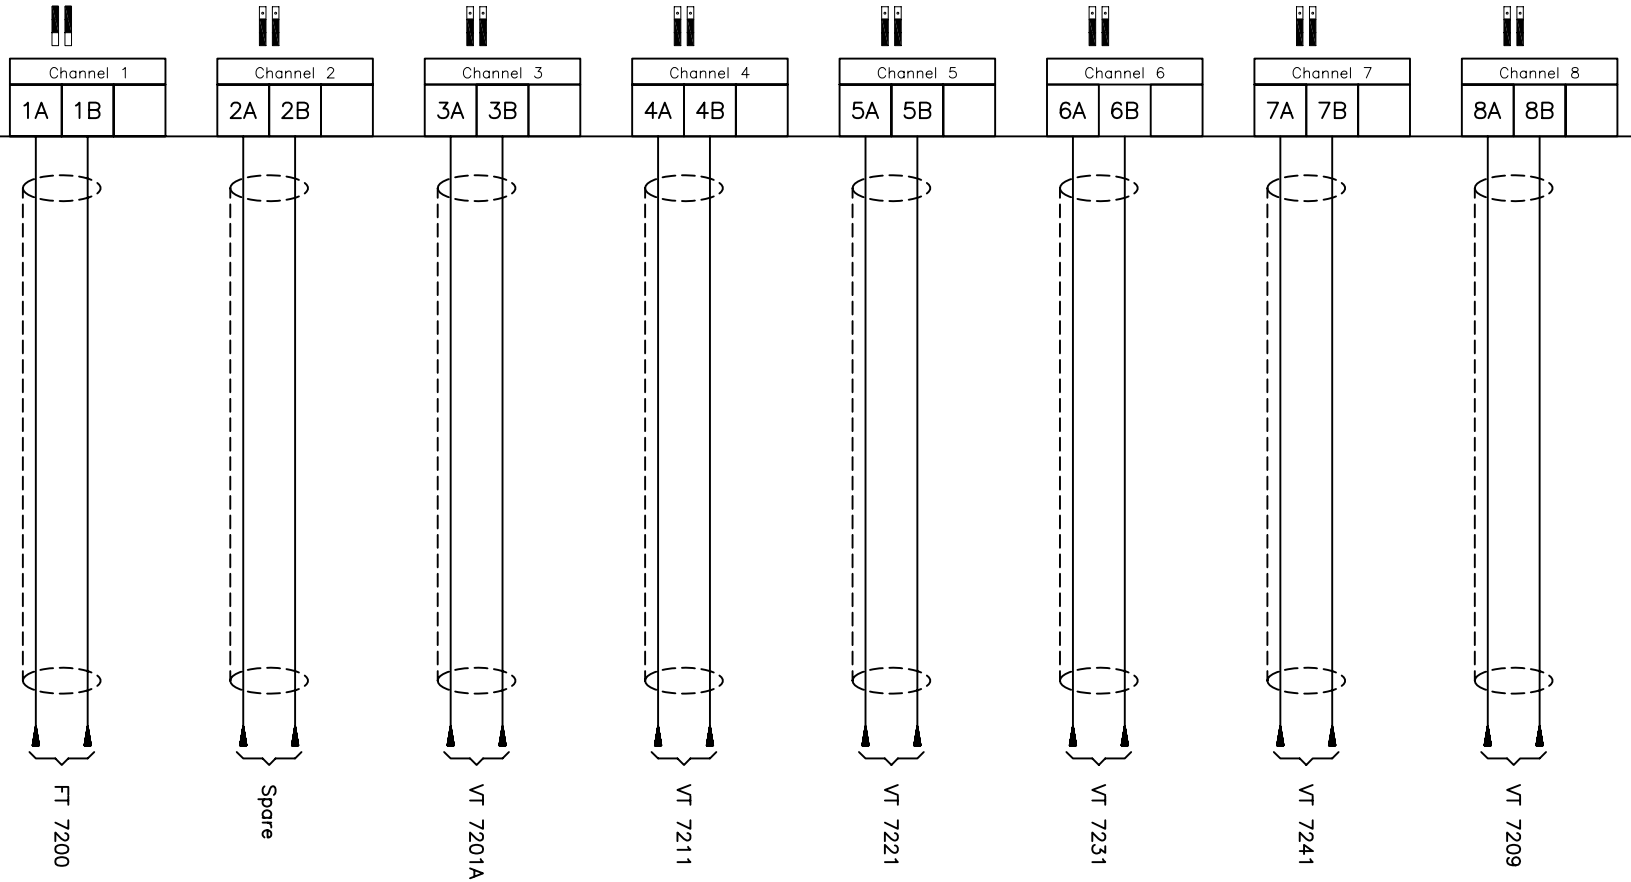


câblage électrique asm / AIR LIQUIDE INGENIERIE	JOB Number 50–2852 Designation ZAPORO	DOCUMENT NUMBER 841–1041	MODIN M1030 DCS CABINET Y1041 Terminals diagram Rack ANR01–04 – Slot 2 AAI135 – 8AI–MIL–R–SW	index	0	PAGE 36/99
	BOOSTER AIR SURPRESSOR			date	13–05–05	
				name	S.P.	
				sign	F.M.	

A1/1312 – P7058–36.DWG – © A.S.M. – ATELIER SEINE ET MARNE – BP25–77241 CESSON CEDEX–TEL:(33) 1.64.79.60.40–FAX:(33) 1.60.63.57.49

Switching Configuration	
3 1 2	Analog input internal power
3 1 2	Analog input external power or Analog output

- YOKOGAWA -

Interface 8AI–MIL–R–SW
Rack ANR01–04 – Slot 3

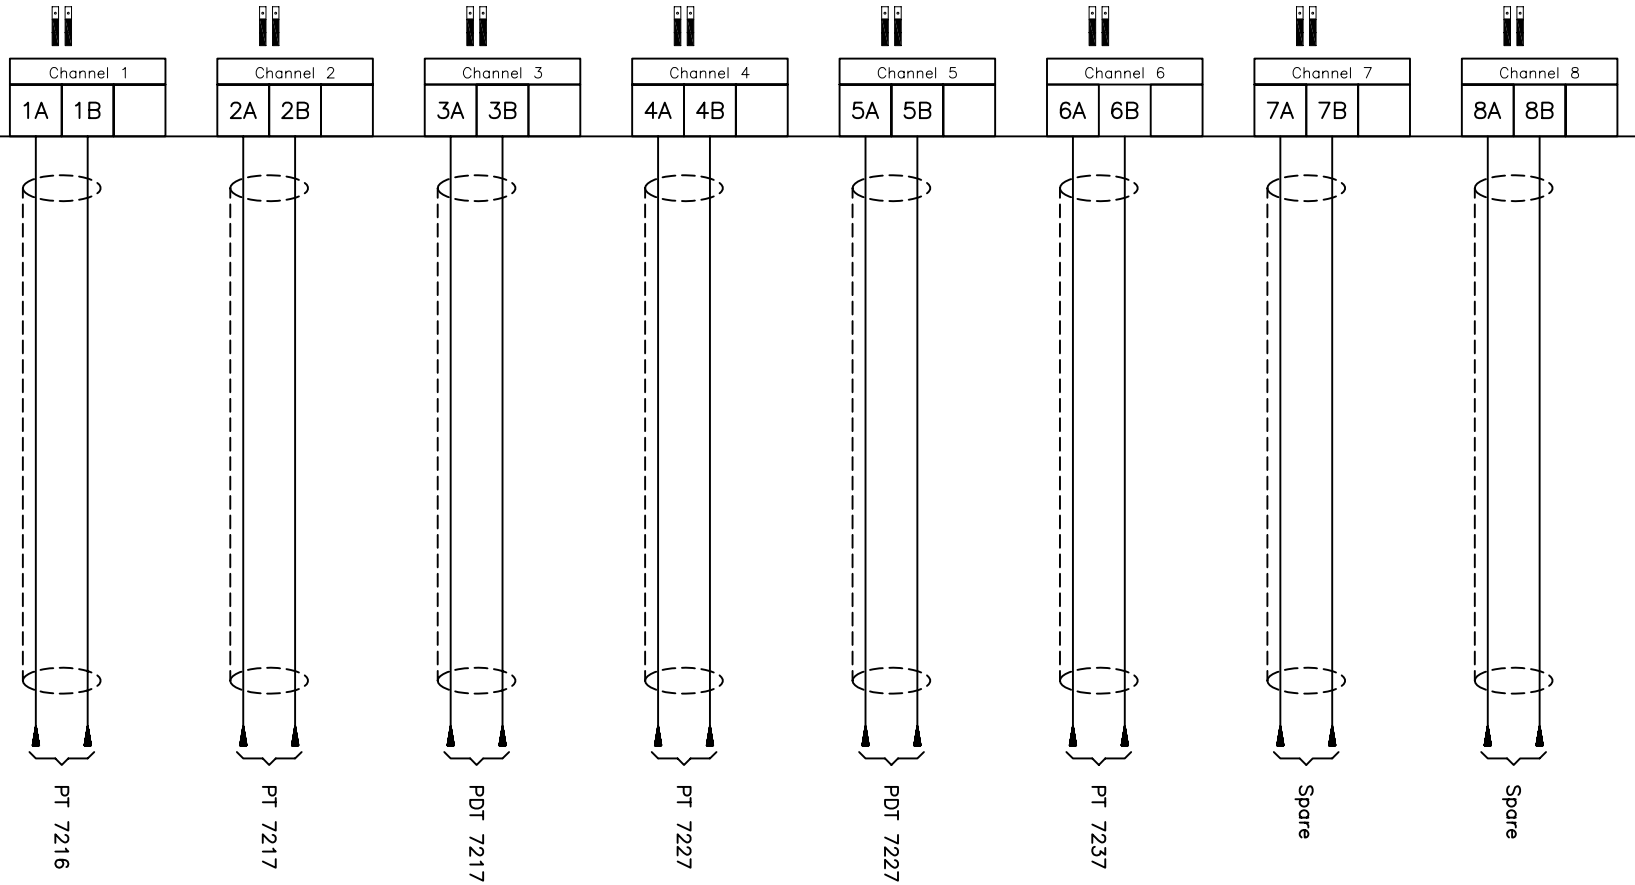

câblage électrique asm / AIR LIQUIDE INGENIERIE	JOB Number 50–2852 Designation ZAPORO	DOCUMENT NUMBER 841–1041	MODIN M1030 DCS CABINET Y1041 Terminals diagram Rack ANR01–04 – Slot 3 AAI135 – 8AI–MIL–R–SW	index	0		PAGE
	BOOSTER AIR SURPRESSOR			date	13–05–05		37 / 99
				name	S.P.		
				sign	F.M.		


A1/1312 – P7058–37.DWG – © A.S.M. – ATELIER SEINE ET MARNE – BP25–77241 CESSON CEDEX–TEL:(33) 1.64.79.60.40–FAX:(33) 1.60.63.57.49

1	2	3	4	5	6	7	8	9

Switching Configuration	
3 1 2	Analog input internal power
3 1 2	Analog input external power or Analog output

- YOKOGAWA -

Interface 8AI–MIL–R–SW
Rack ANR01–04 – Slot 4

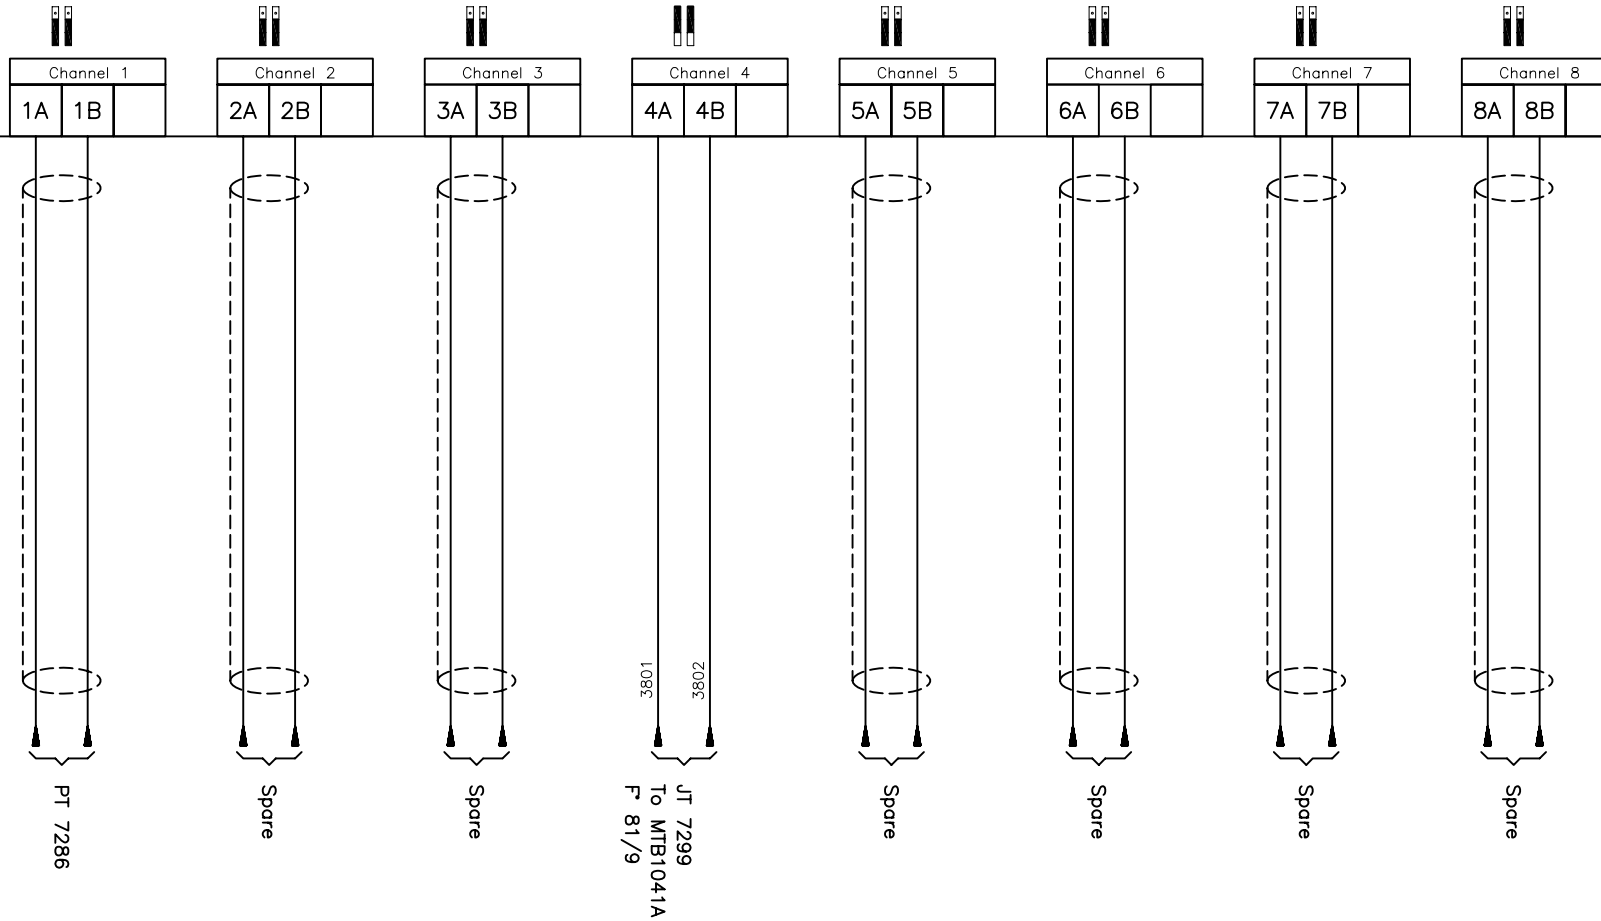


câblage électrique asm / AIR LIQUIDE INGENIERIE	JOB Number 50–2852 Designation ZAPORO	DOCUMENT NUMBER 841–1041	MODIN M1030 DCS CABINET Y1041 Terminals diagram Rack ANR01–04 – Slot 4 AAI135 – 8AI–MIL–R–SW	index	0					PAGE 38/99
	BOOSTER AIR SURPRESSOR			date	13–05–05					
				name	S.P.					
				sign	F.M.					

A1/1312 – P7058–38.DWG – © A.S.M. – ATELIER SEINE ET MARNE – BP25–77241 CESSON CEDEX–TEL:(33) 1.64.79.60.40–FAX:(33) 1.60.63.57.49

- YOKOGAWA -

Interface 16RTD–KS–R
Rack ANR01–04 – Slot 5

Part 1/2

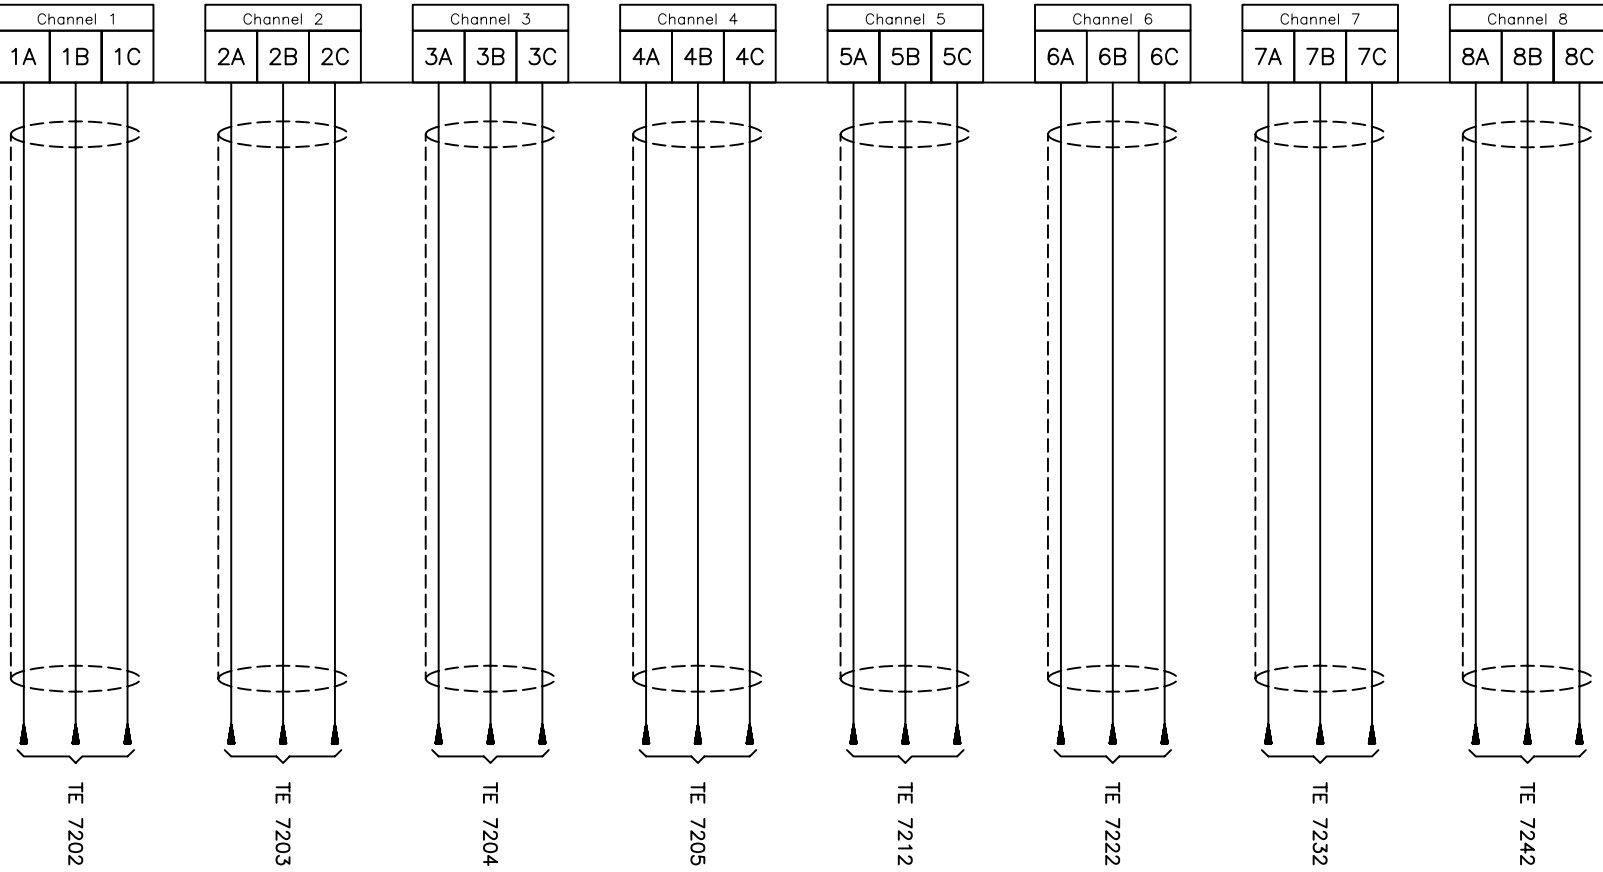


câblage électrique asm / AIR LIQUIDE INGENIERIE	JOB Number 50–2852 Designation ZAPORO	DOCUMENT NUMBER 841–1041	MODIN M1030 DCS CABINET Y1041 Terminals diagram Rack ANR01–04 – Slot 5 AAR145 – 16RTD–KS–R	index	0		PAGE
	BOOSTER AIR SURPRESSOR			date	13–05–05		39 / 99
				name	S.P.		
				sign	F.M.		

A1/1312 – P7058–39.DWG – © A.S.M. – ATELIER SEINE ET MARNE – BP25–77241 CESSON CEDEX–TEL.:(33) 1.64.79.60.40–FAX:(33) 1.60.63.57.49

- YOKOGAWA -

Part 2/2

Interface 16RTD–KS–R
Rack ANR01–04 – Slot 5

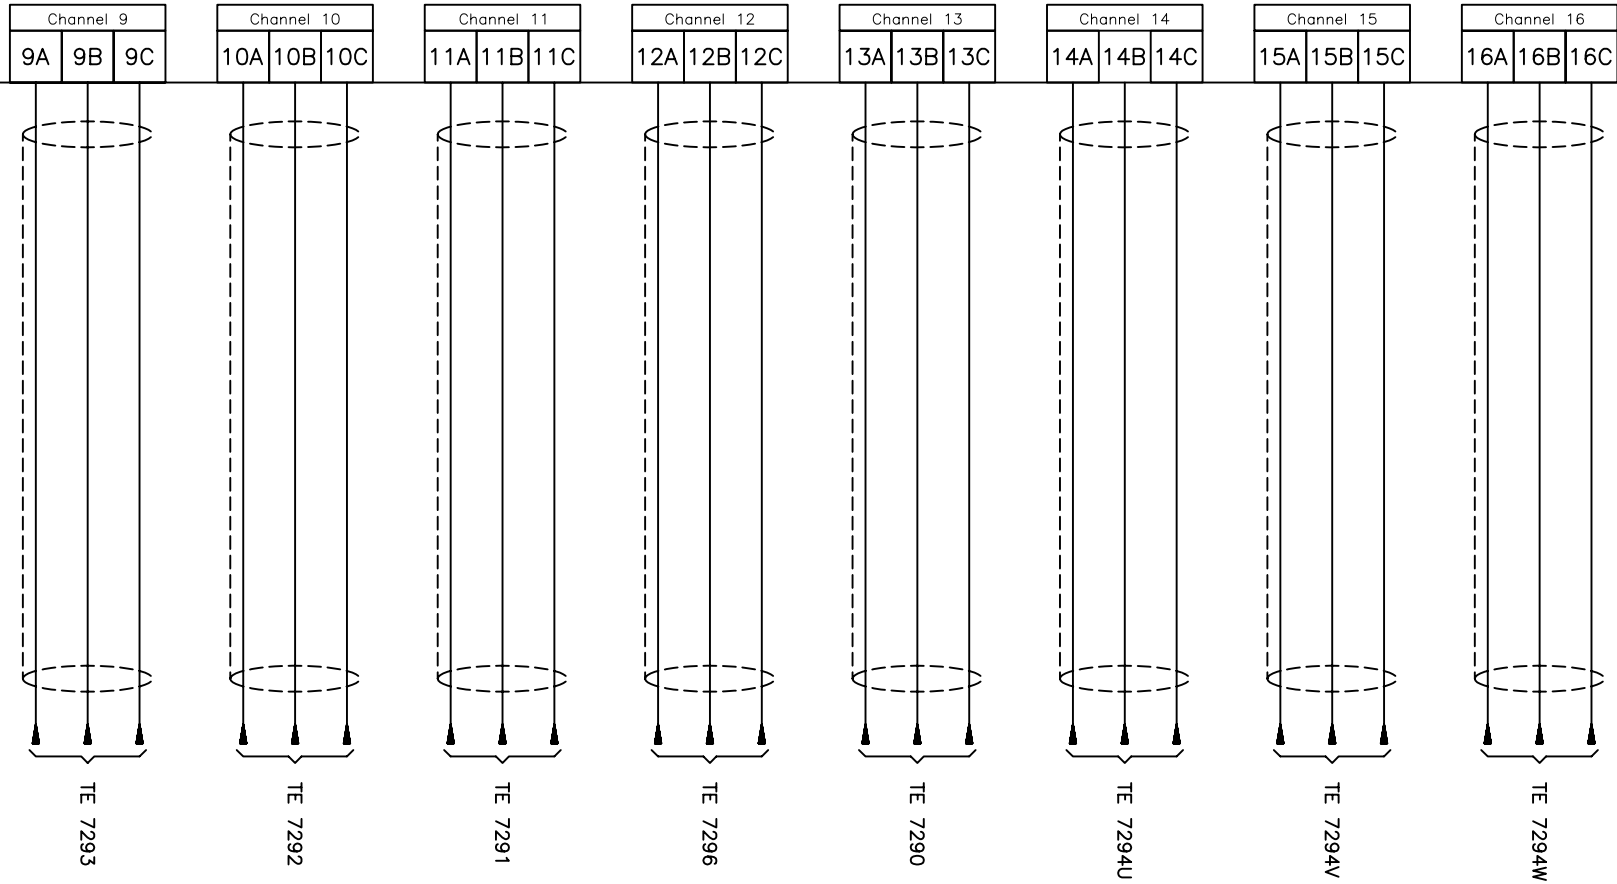

câblage électrique asm / AIR LIQUIDE INGENIERIE	JOB Number 50–2852 Designation ZAPORO	DOCUMENT NUMBER 841–1041	MODIN M1030 DCS CABINET Y1041 Terminals diagram Rack ANR01–04 – Slot 5 AAR145 – 16RTD–KS–R	index 0 date 13–05–05 name S.P. sign F.M.		PAGE 40 / 99
	BOOSTER AIR SURPRESSOR					


A1/1312 – P7058–40.DWG – © A.S.M. – ATELIER SEINE ET MARNE – BP25–77241 CESSON CEDEX–TEL.:(33) 1.64.79.60.40–FAX:(33) 1.60.63.57.49

1	2	3	4	5	6	7	8	9

- YOKOGAWA -

Interface 16RTD–KS–R
Rack ANR01–04 – Slot 6

Part 1/2

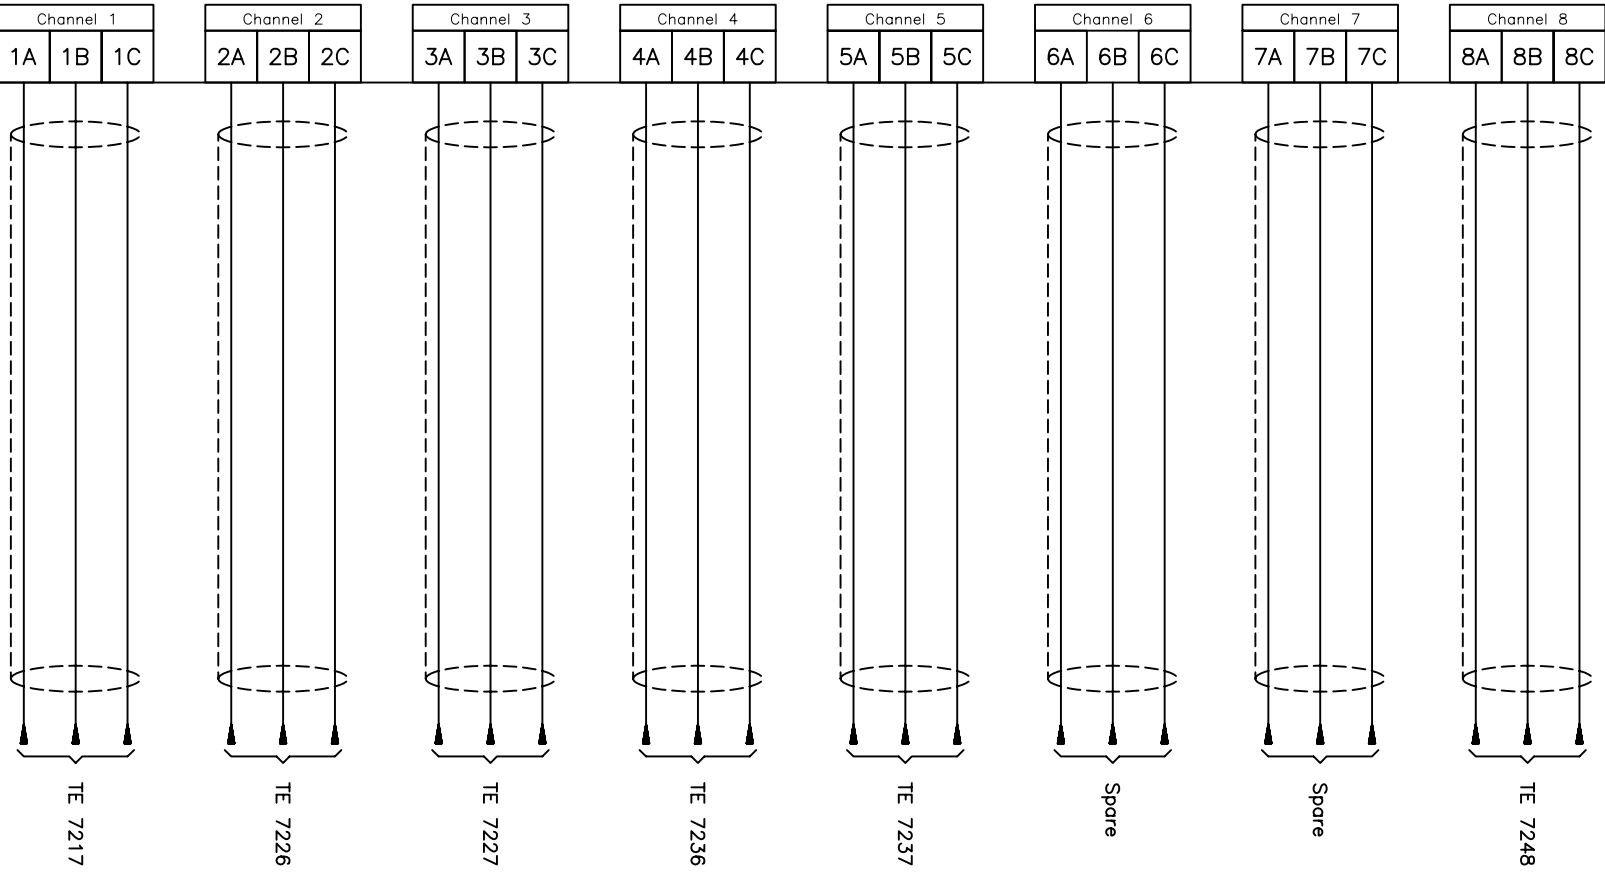


câblage électrique asm	JOB Number 50–2852 Designation ZAPORO	DOCUMENT NUMBER 841–1041	MODIN M1030 DCS CABINET Y1041 Terminals diagram Rack ANR01–04 – Slot 6 AAR145 – 16RTD–KS–R	index	0	PAGE
AIR LIQUIDE INGENIERIE	BOOSTER AIR SURPRESSOR			date	13–05–05	41/99
				name	S.P.	
				sign	F.M.	

A1/1312 – P7058–41.DWG – © A.S.M. – ATELIER SEINE ET MARNE – BP25–77241 CESSON CEDEX–TEL.:(33) 1.64.79.60.40–FAX:(33) 1.60.63.57.49

- YOKOGAWA -


Part 2/2

Interface 16RTD–KS–R
Rack ANR01–04 – Slot 6

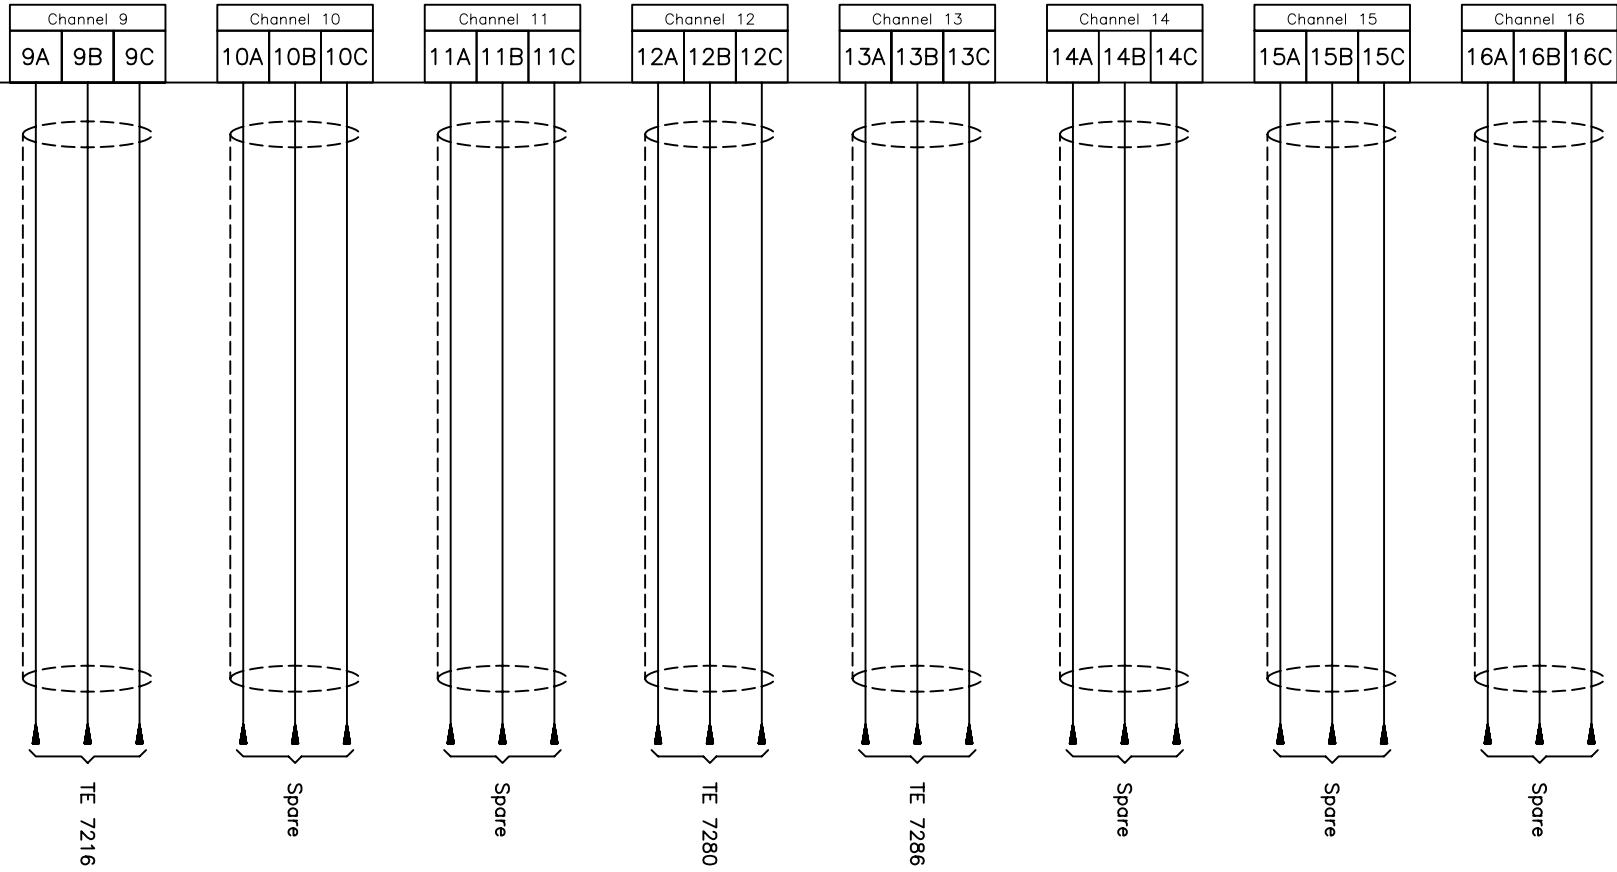

câblage électrique asm / AIR LIQUIDE INGENIERIE	JOB Number 50–2852 Designation ZAPORO	DOCUMENT NUMBER 841–1041	MODIN M1030 DCS CABINET Y1041 Terminals diagram Rack ANR01–04 – Slot 6 AAR145 – 16RTD–KS–R	index 0					PAGE 42/99
	BOOSTER AIR SURPRESSOR			date 13–05–05					
				name S.P.					
				sign F.M.					

A1/1312 – P7058–42.DWG – © A.S.M. – ATELIER SEINE ET MARNE – BP25–77241 CESSON CEDEX–TEL.:(33) 1.64.79.60.40–FAX:(33) 1.60.63.57.49

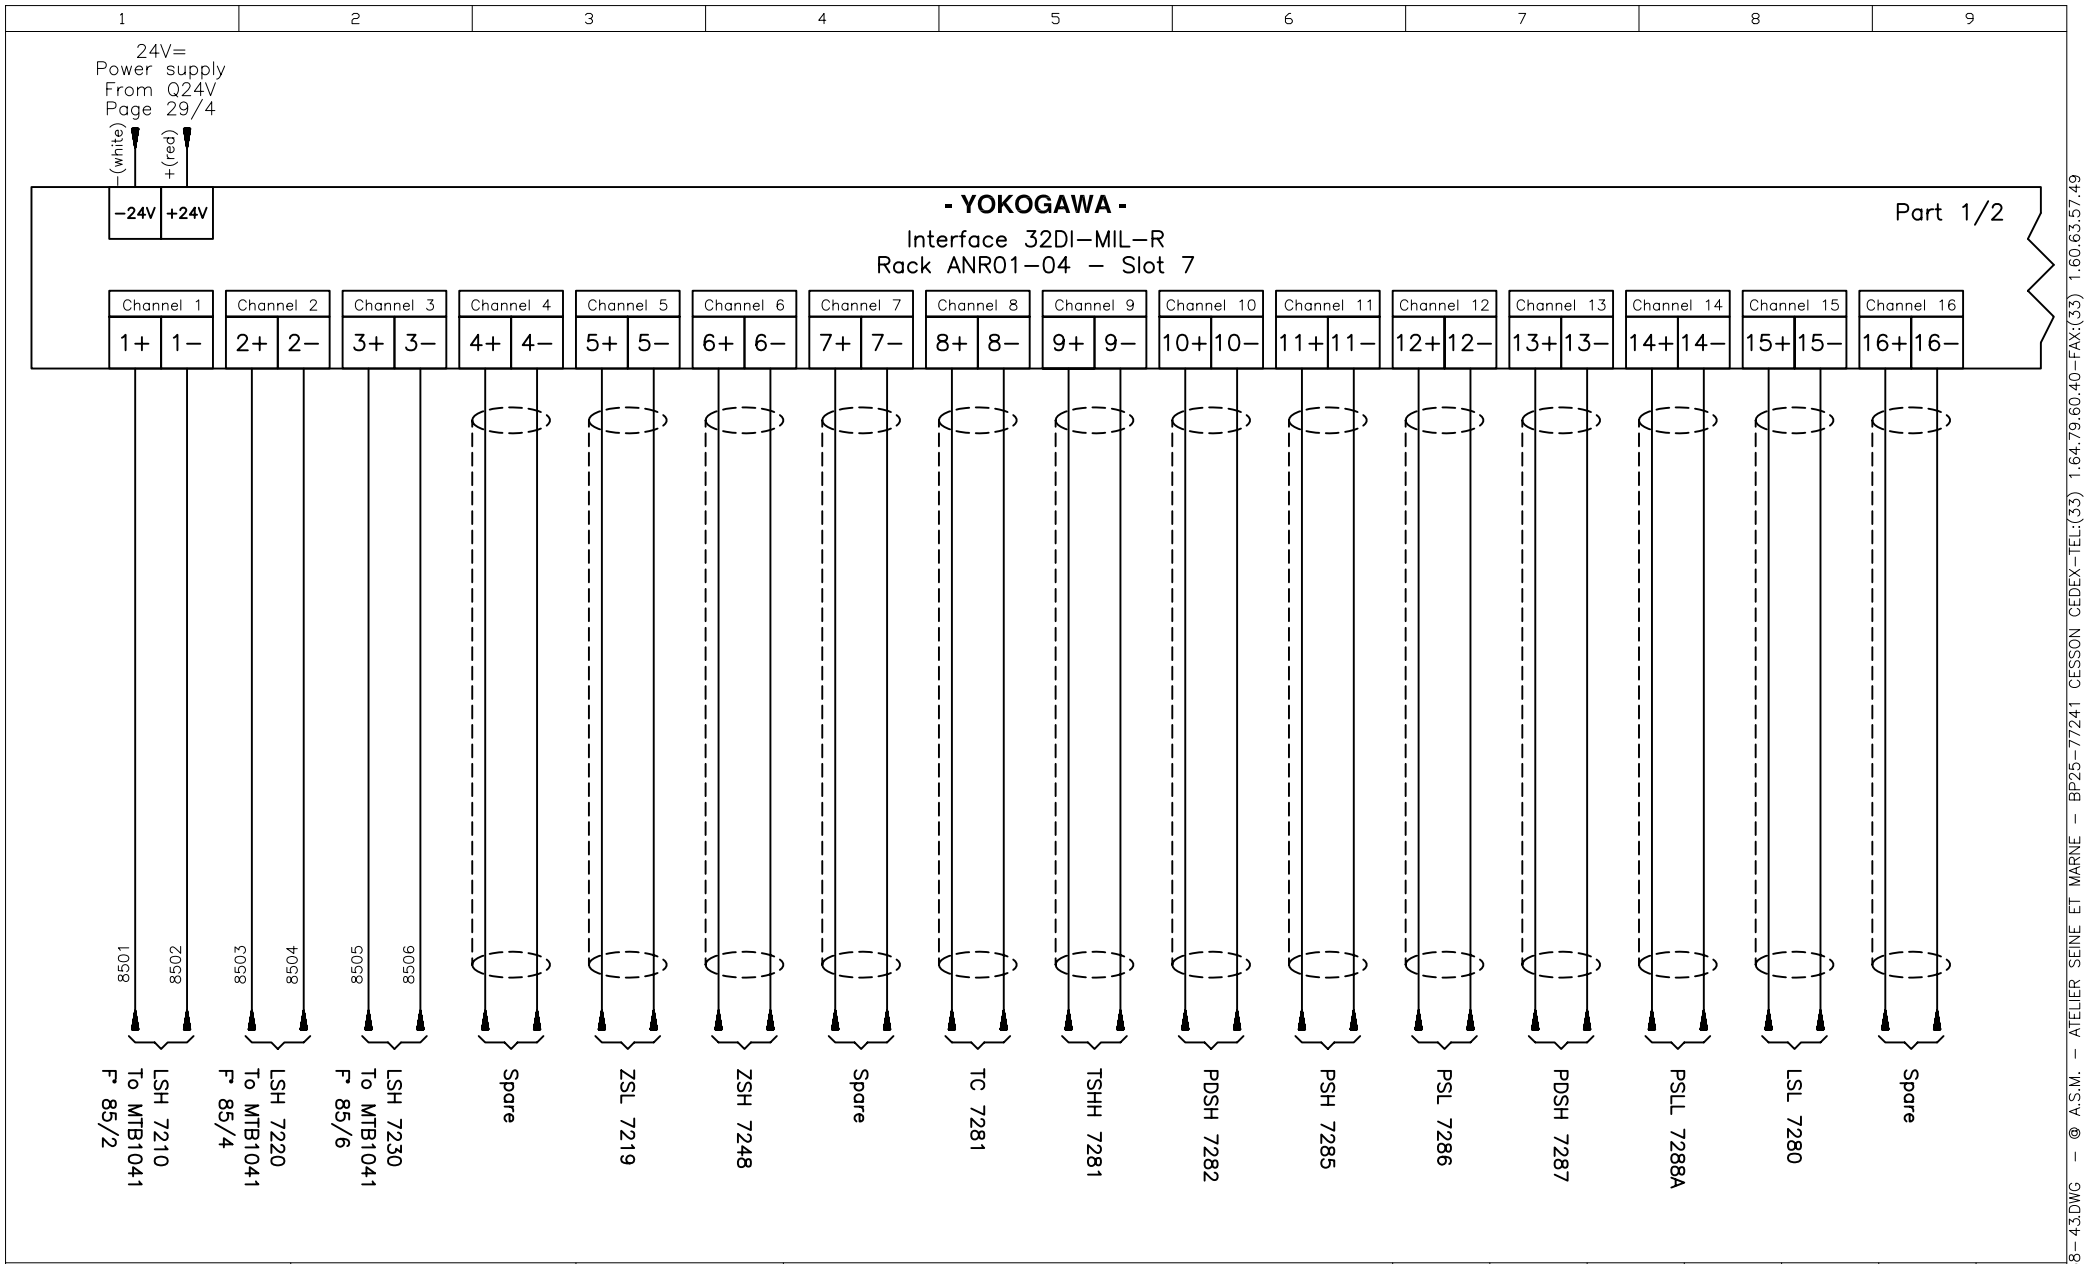

câblage électrique asm

AIR LIQUIDE INGENIERIE

JOB Number	50−2852	DOCUMENT NUMBER
Designation	ZAPORO	841−1041
BOOSTER AIR SURPRESSOR		

MODIN M1030
DCS CABINET Y1041
Terminals diagram
Rack ANR01−04 − Slot 7
ADV151 − 32DI−MIL−R


index	0					PAGE
date	13−05−05					43 / 99
name	S.P.					
sign	F.M.					

A1/1312 − P7058−43.DWG − © A.S.M. − ATELIER SEINE ET MARNE − BP25−77241 CESSON CEDEX−TEL.:(33) 1.64.79.60.40−FAX:(33) 1.60.63.57.49

- YOKOGAWA -


Part 2/2

Interface 32DI–MIL–R
Rack ANR01–04 – Slot 7

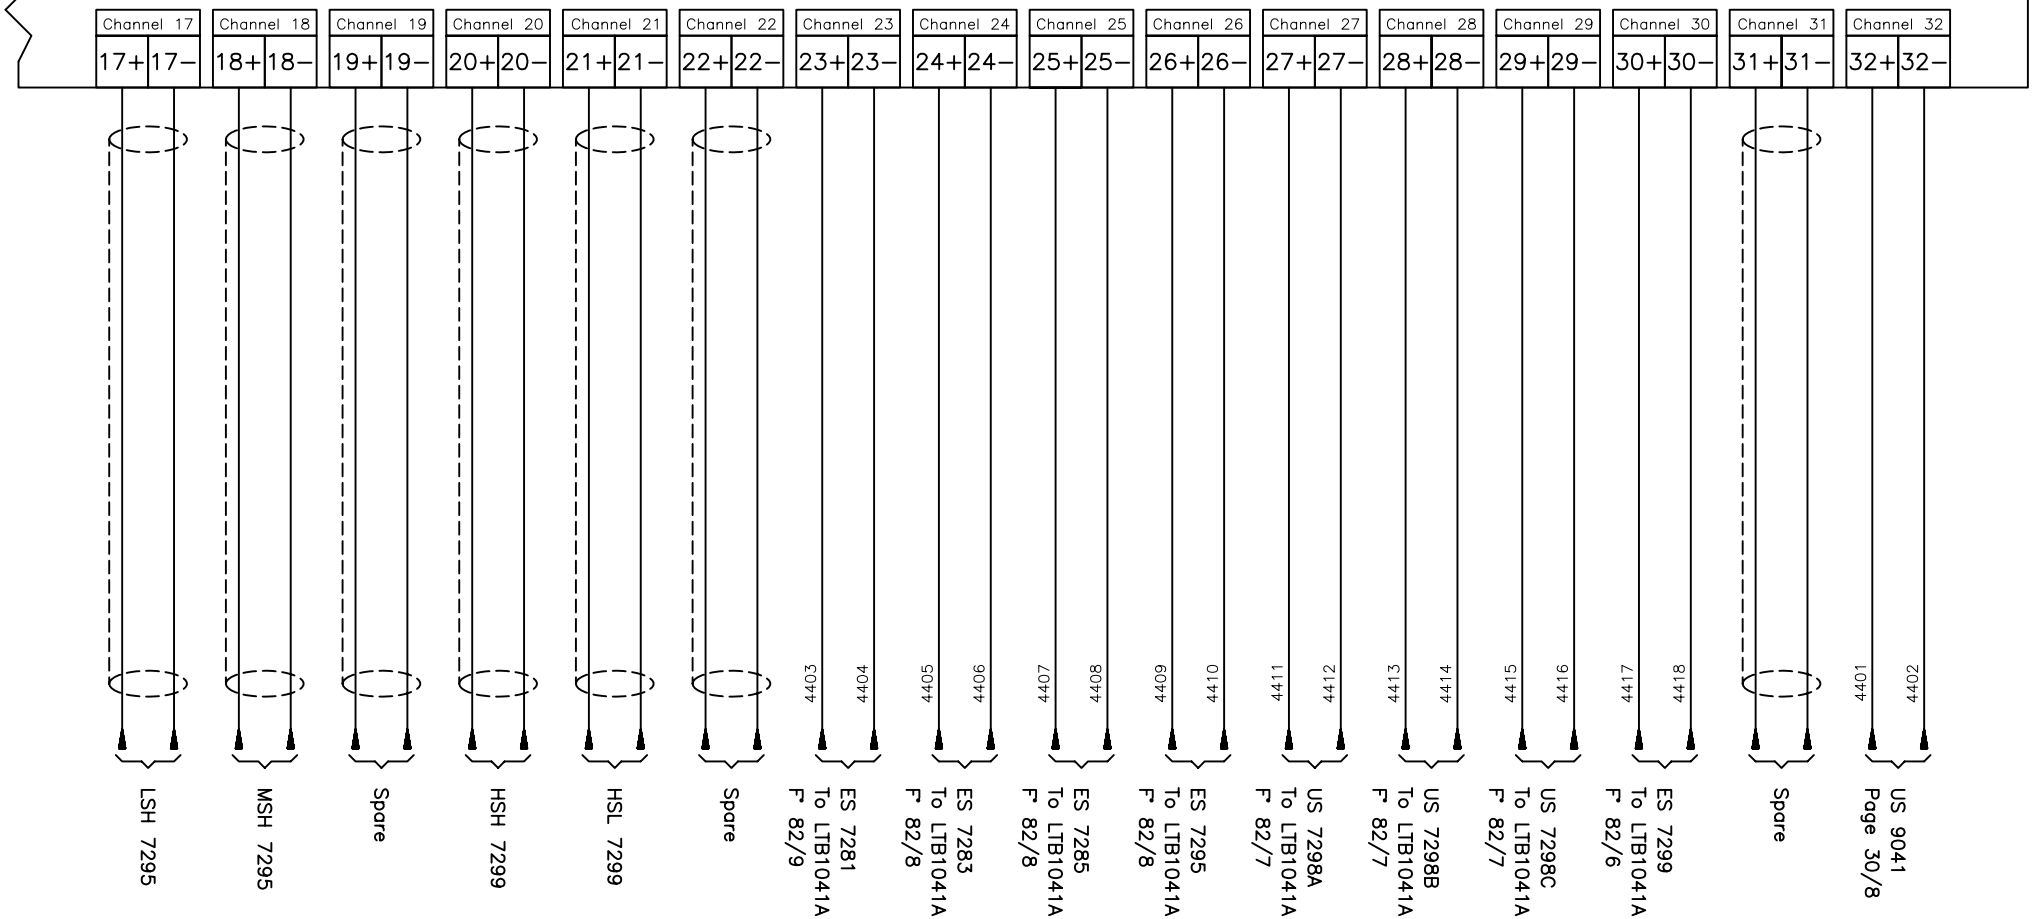

câblage électrique asm / AIR LIQUIDE INGENIERIE	JOB Number 50–2852 Designation ZAPORO	DOCUMENT NUMBER 841–1041	MODIN M1030 DCS CABINET Y1041 Terminals diagram Rack ANR01–04 – Slot 7 ADV151 – 32DI–MIL–R	index	0					PAGE 44/99
	BOOSTER AIR SURPRESSOR			date	13–05–05					
				name	S.P.					
				sign	F.M.					

A1/1312 – P7058–44.DWG – © A.S.M. – ATELIER SEINE ET MARNE – BP25–77241 CESSON CEDEX–TEL.:(33) 1.64.79.60.40–FAX:(33) 1.60.63.57.49

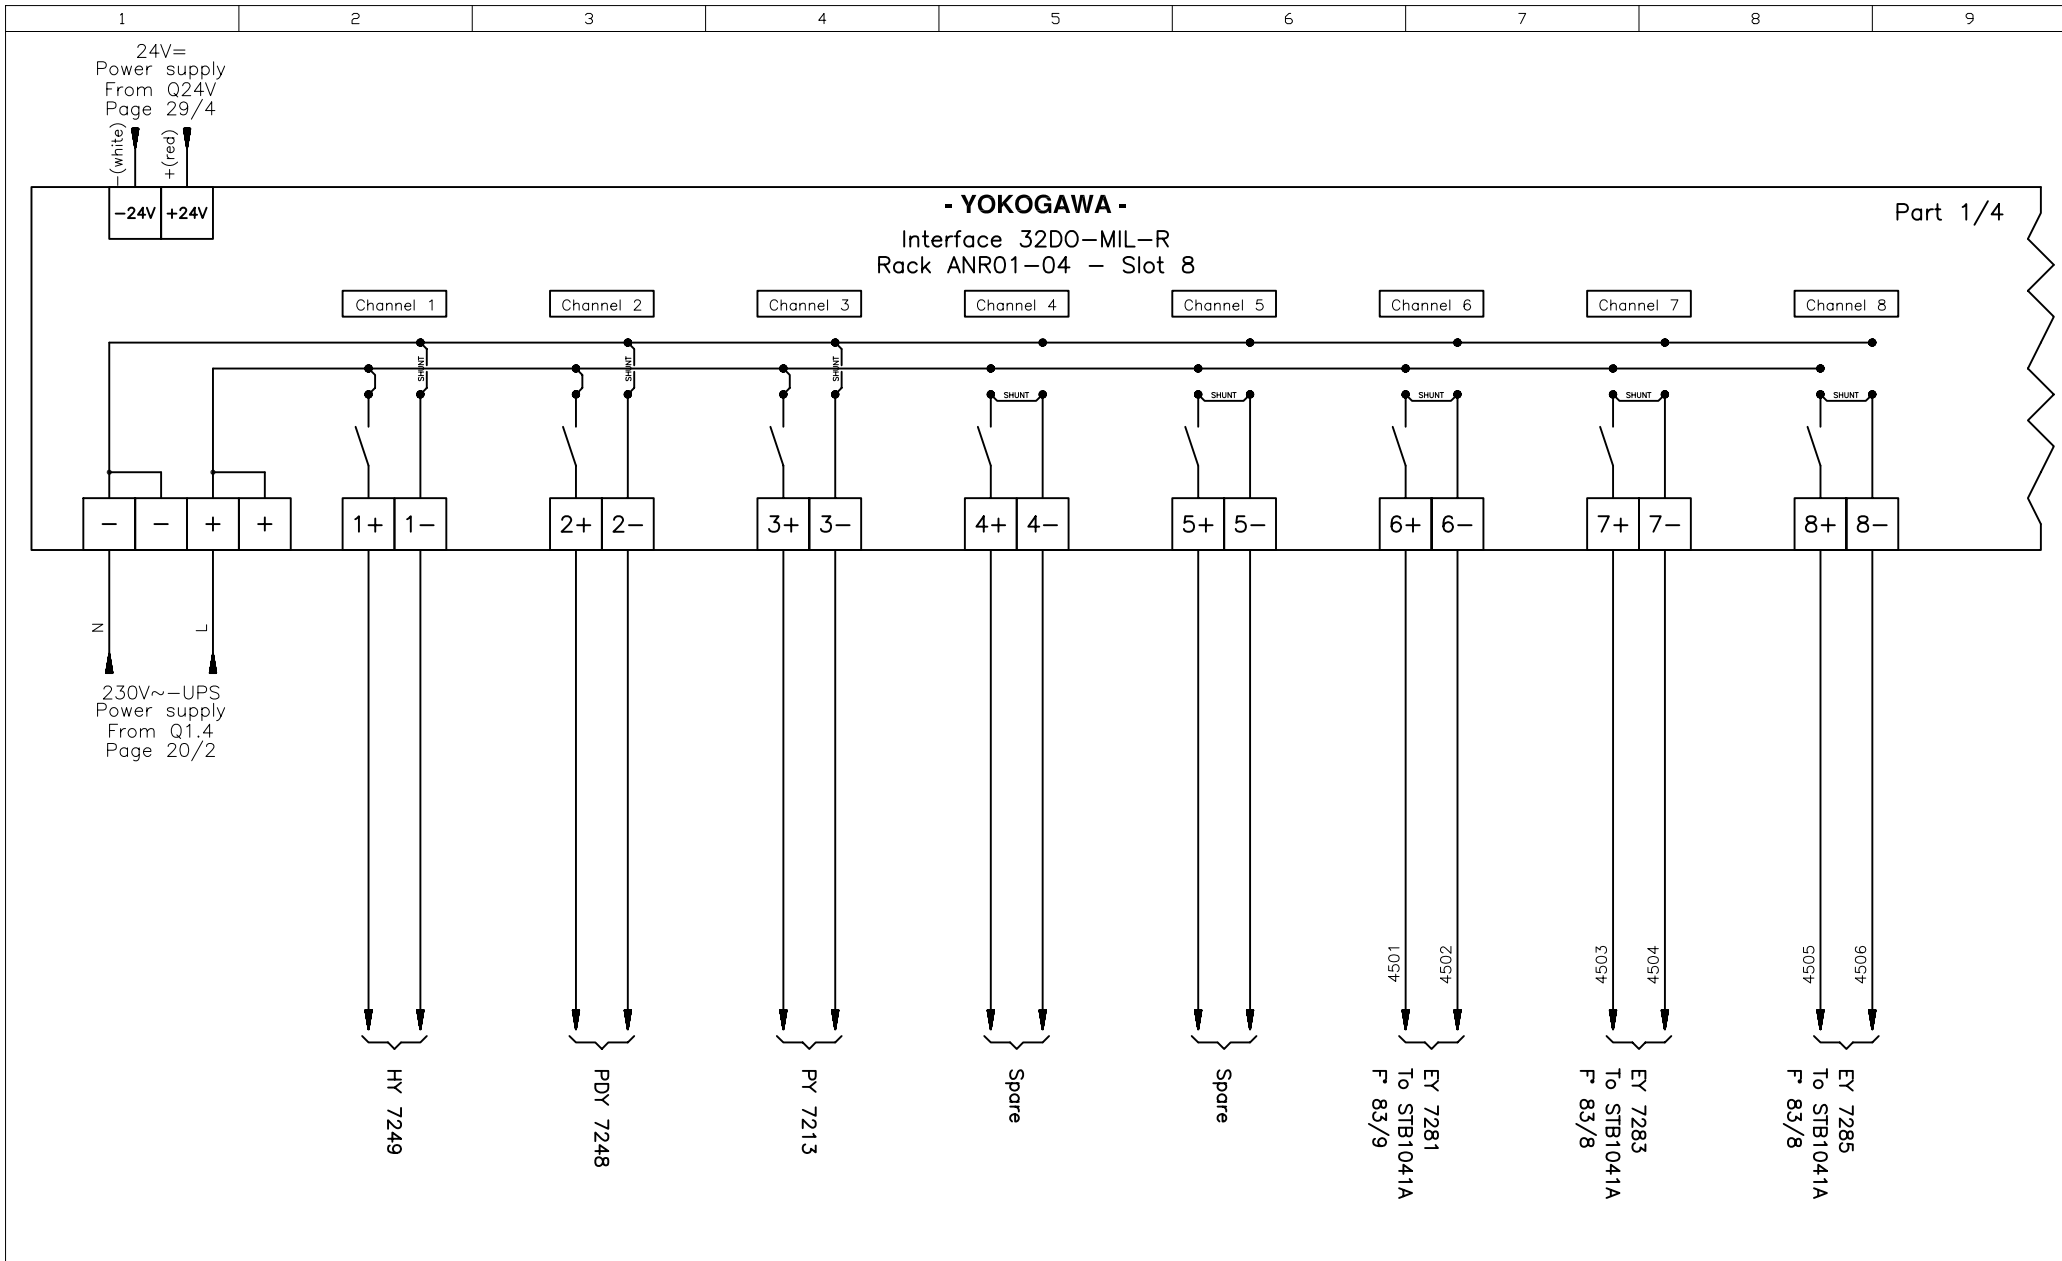


câblage électrique asm / AIR LIQUIDE INGENIERIE	JOB Number 50−2852 Designation ZAPORO	DOCUMENT NUMBER 841−1041	MODIN M1030 DCS CABINET Y1041 Terminals diagram Rack ANR01−04 − Slot 8 ADV551 − 32DO−MIL−R	index	0					PAGE 45/99
	BOOSTER AIR SURPRESSOR			date	13−05−05					
				name	S.P.					
				sign	F.M.					

A1/1312 − P7058−45.DWG − © A.S.M. − ATELIER SEINE ET MARNE − BP25−77241 CESSON CEDEX−TEL.:(33) 1.64.79.60.40−FAX:(33) 1.60.63.57.49

- YOKOGAWA -

Part 2/4

Interface 32DO–MIL–R
Rack ANR01–04 – Slot 8

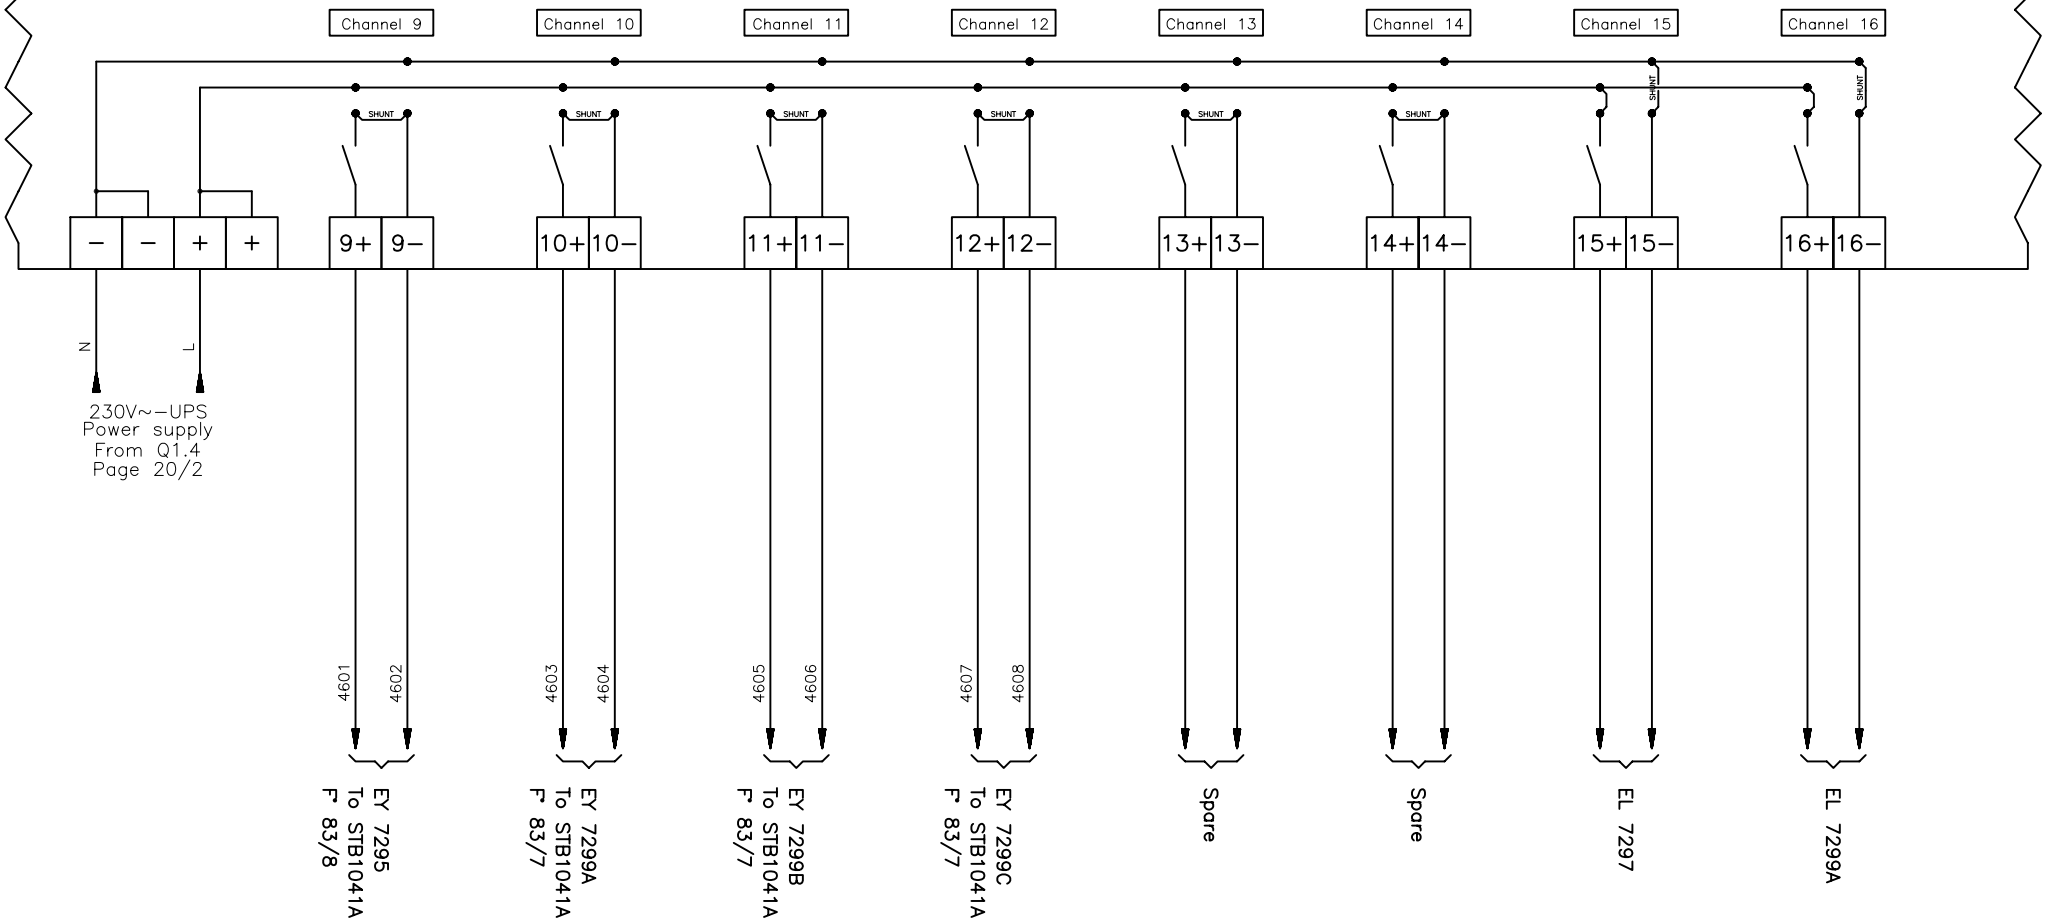


câblage électrique asm / AIR LIQUIDE INGENIERIE	JOB Number 50–2852 Designation ZAPORO	DOCUMENT NUMBER 841–1041	MODIN M1030 DCS CABINET Y1041 Terminals diagram Rack ANR01–04 – Slot 8 ADV551 – 32DO–MIL–R	index	0					PAGE 46/99
	BOOSTER AIR SURPRESSOR			date	13–05–05					
				name	S.P.					
				sign	F.M.					

A1/1312 – P7058–46.DWG – © A.S.M. – ATELIER SEINE ET MARNE – BP25–77241 CESSON CEDEX–TEL.:(33) 1.64.79.60.40–FAX:(33) 1.60.63.57.49

- YOKOGAWA -

Part 3/4

Interface 32DO–MIL–R
Rack ANR01–04 – Slot 8

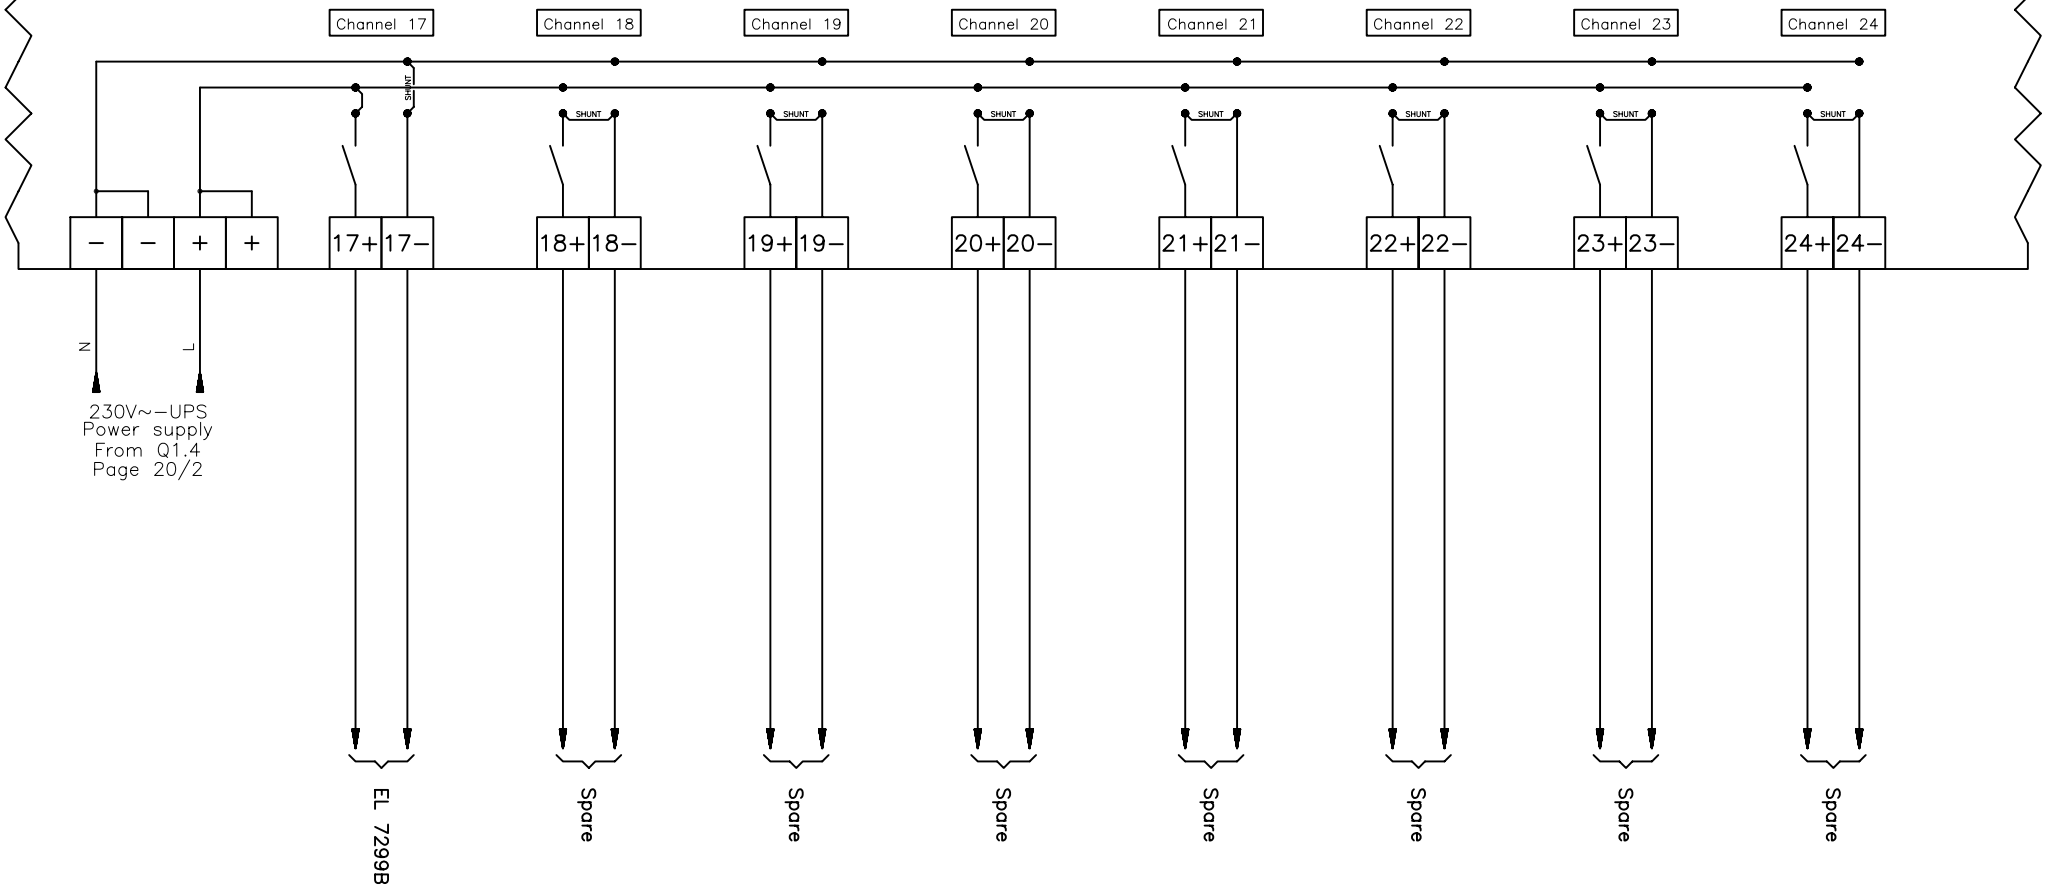


câblage électrique asm / AIR LIQUIDE INGENIERIE	JOB Number 50–2852 Designation ZAPORO	DOCUMENT NUMBER 841–1041	MODIN M1030 DCS CABINET Y1041 Terminals diagram Rack ANR01–04 – Slot 8 ADV551 – 32DO–MIL–R	index	0		PAGE
	BOOSTER AIR SURPRESSOR			date	13–05–05		47 / 99
				name	S.P.		
				sign	F.M.		

A1/1312 – P7058–47.DWG – © A.S.M. – ATELIER SEINE ET MARNE – BP25–77241 CESSON CEDEX–TEL.:(33) 1.64.79.60.40–FAX:(33) 1.60.63.57.49

- YOKOGAWA -


Part 4/4

Interface 32DO–MIL–R
Rack ANR01–04 – Slot 8

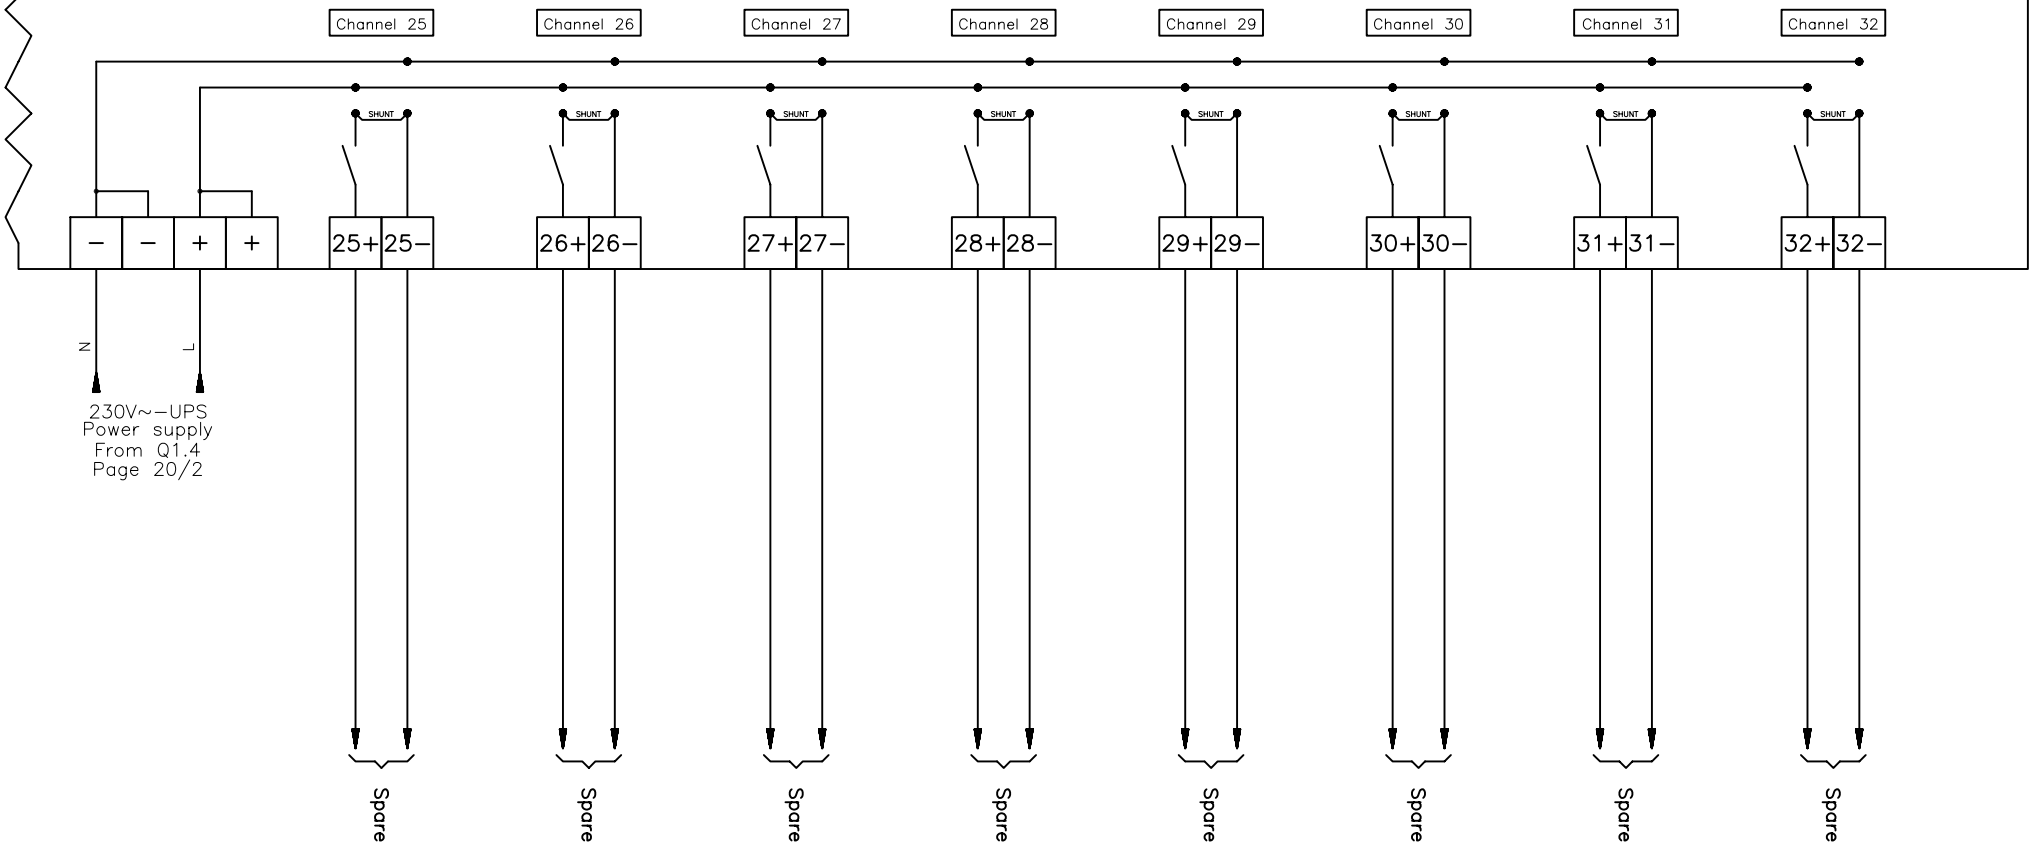


câblage électrique asm / AIR LIQUIDE INGENIERIE	JOB Number 50–2852 Designation ZAPORO	DOCUMENT NUMBER 841–1041	MODIN M1030 DCS CABINET Y1041 Terminals diagram Rack ANR01–04 – Slot 8 ADV551 – 32DO–MIL–R	index	0		PAGE
	BOOSTER AIR SURPRESSOR			date	13–05–05		48 / 99
				name	S.P.		
				sign	F.M.		

A1/1312 – P7058–48.DWG – © A.S.M. – ATELIER SEINE ET MARNE – BP25–77241 CESSON CEDEX–TEL.:(33) 1.64.79.60.40–FAX:(33) 1.60.63.57.49

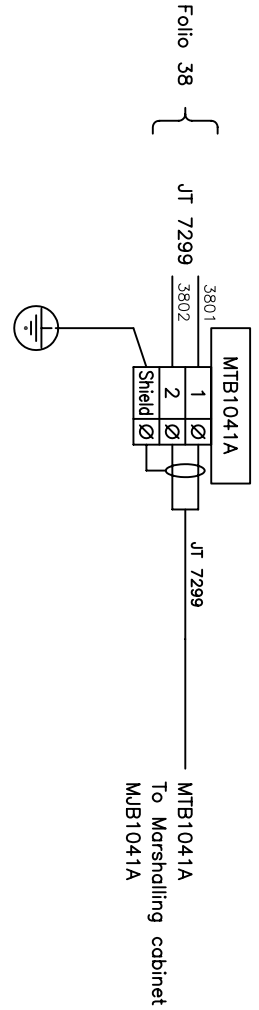


câblage électrique asm	JOB Number 50–2852 Designation ZAPORO	DOCUMENT NUMBER 841–1041	MODIN M1030 DCS CABINET Y1041 Terminals blocks MTB 1041A	index	0					PAGE
AIR LIQUIDE INGENIERIE	BOOSTER AIR SURPRESSOR			date	13–05–05					81/99
				name	S.P.					
				sign	F.M.					

A1/1312 – P7058–81.DWG – © A.S.M. – ATELIER SEINE ET MARNE – BP25–77241 CESSON CEDEX–TEL:(33) 1.64.79.60.40–FAX:(33) 1.60.63.57.49

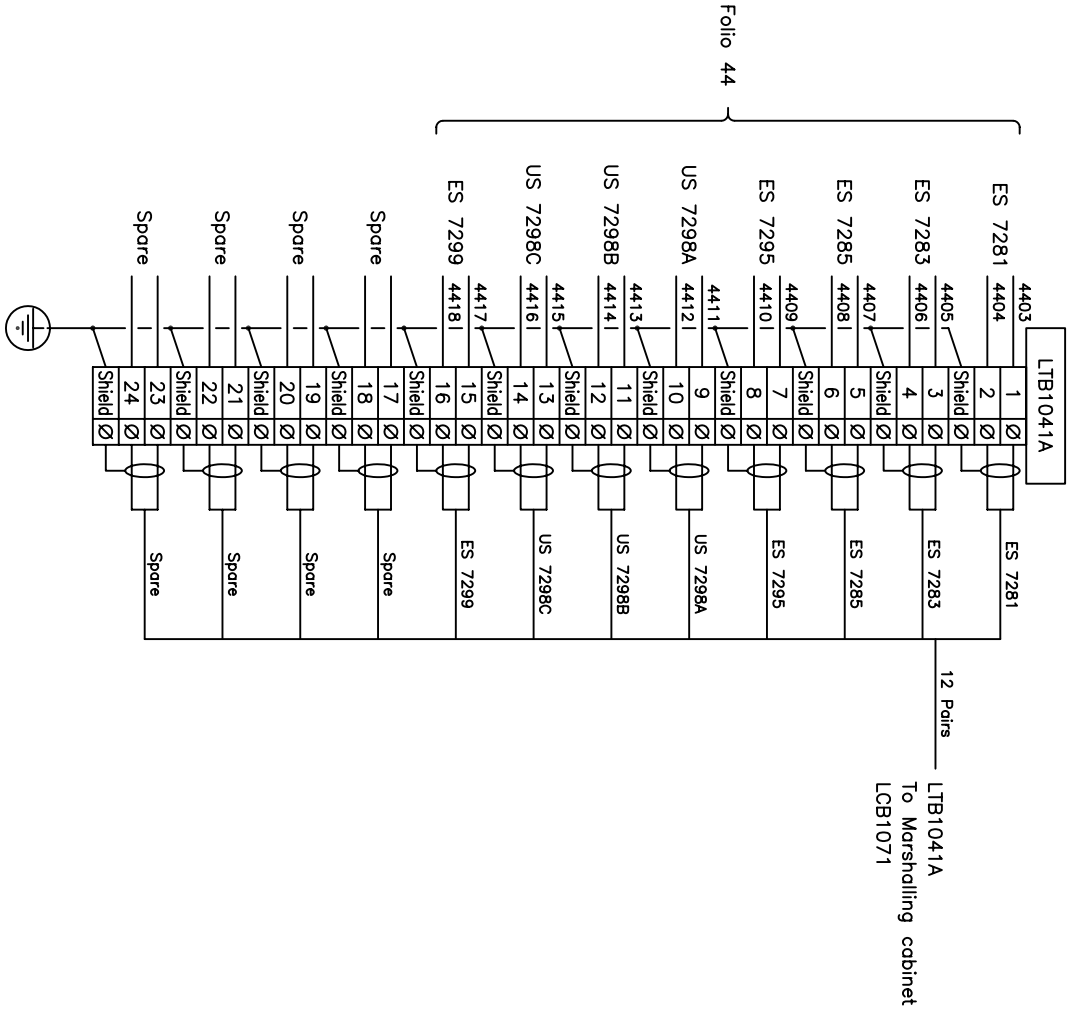


câblage électrique asm / AIR LIQUIDE INGENIERIE	JOB Number 50–2852 Designation ZAPORO	DOCUMENT NUMBER 841–1041	MODIN M1030 DCS CABINET Y1041 Terminals blocks LTB 1041A	index	0					PAGE 82/99
	BOOSTER AIR SURPRESSOR			date	13–05–05					
				name	S.P.					
				sign	F.M.					

A1/1312 – P7058–82.DWG – © A.S.M. – ATELIER SEINE ET MARNE – BP25–77241 CESSON CEDEX–TEL.:(33) 1.64.79.60.40–FAX:(33) 1.60.63.57.49

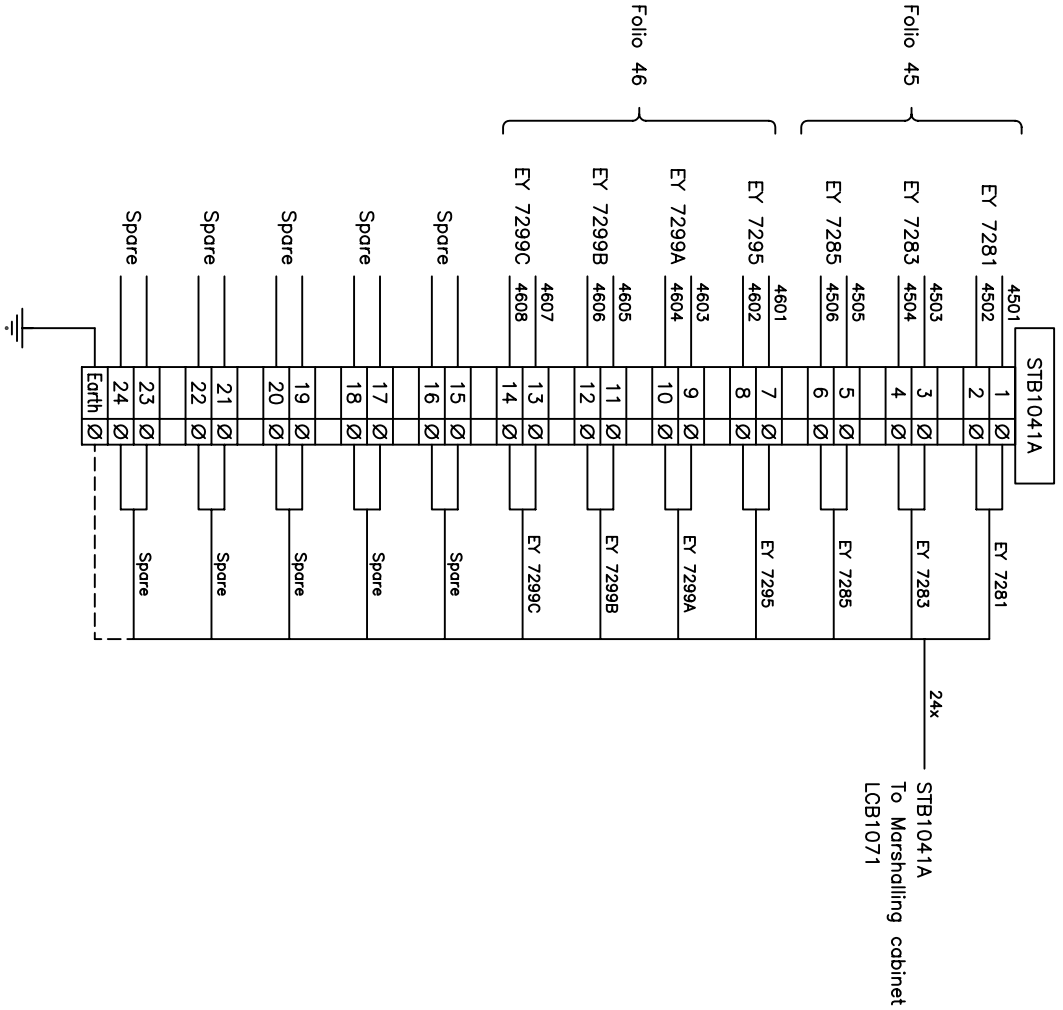

câblage électrique asm	JOB Number 50–2852	DOCUMENT NUMBER	MODIN M1030	index	0		PAGE
	Designation ZAPORO	841–1041	DCS CABINET Y1041	date	13–05–05		83 / 99
AIR LIQUIDE INGENIERIE	BOOSTER AIR SURPRESSOR		Terminals blocks STB 1041A	name	S.P.		
				sign	F.M.		

A1/1312 – P7058–83.DWG – © A.S.M. – ATELIER SEINE ET MARNE – BP25–77241 CESSON CEDEX–TEL.:(33) 1.64.79.60.40–FAX:(33) 1.60.63.57.49

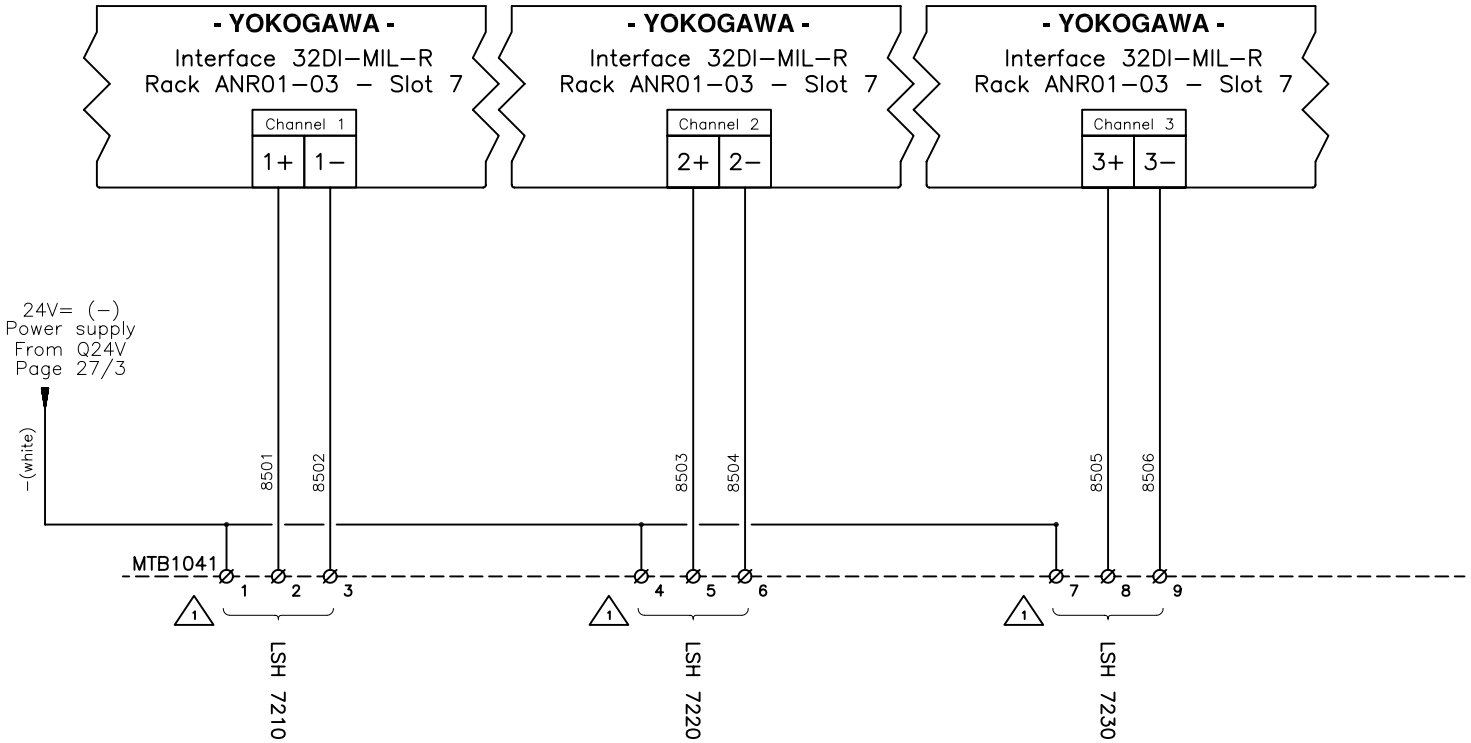

JOB Number / Designation: 50–2852 ZAPORO	DOCUMENT NUMBER: 841–1041	MODIN M1030 DCS CABINET Y1041 Terminals diagram Level Switch Mobrey –	index	0	1	PAGE
BOOSTER AIR SURPRESSOR			date	13–05–05	26–07–05	85/99
			name	S.P.	S.P.	
			sign	F.M.	F.M.	

A1/1312 – P7058–85.DWG – © A.S.M. – ATELIER SEINE ET MARNE – BP25–77241 CESSON CEDEX–TEL:(33) 1.64.79.60.40–FAX:(33) 1.60.63.57.49

TAG	DESIGNATION	REFERENCE	FIRM	QTY	REMARKS
PANEL	Base frame, top frame and roof – Spacial 6000 enclosure kit – 2000x800x800	67088	SAREL	1	
	Set of 4 uprights	60020	SAREL	1	
	Set of 2 side panels	61048	SAREL	0	
	Plain doors	67228	SAREL	1	
	Screwed panel	67378	SAREL	0	
	Lock 1242E	63703	SAREL	1	
	Plinth 100mm	69088	SAREL	1	
	Kit of juxtaposition	64620	SAREL	0	

câblage électrique asm

AIR LIQUIDE INGENIERIE

JOB Number 50–2852
Designation ZAPORO

DOCUMENT NUMBER 841–1041

BOOSTER AIR SURPRESSOR

MODIN M1030
DCS CABINET Y1041
Equipment list

index	0					PAGE
date	13–05–05					95/99
name	S.P.					
sign	F.M.					

A1/1312 – P7058–95.DWG – © A.S.M. – ATELIER SEINE ET MARNE – BP25–77241 CESSON CEDEX–TEL:(33) 1.64.79.60.40–FAX:(33) 1.60.63.57.49

TAG	DESIGNATION	REFERENCE	FIRM	QTY	REMARKS
Q1	Isolator type I 2x32A with red light	15101	MERLIN GERIN	1	
	Auxiliary contact NO/NC for Isolator I	15096	MERLIN GERIN	1	
Q1.1	Circuit breaker type C60N 2x10A – curve D	24586	MERLIN GERIN	1	
	Fault auxiliary contact for C60N	26927	MERLIN GERIN	1	
Q1.4	Circuit breaker type C60N 2x10A – curve C	24201	MERLIN GERIN	1	
	Fault auxiliary contact for C60N	26927	MERLIN GERIN	1	
Q1.2–Q1.3	Circuit breaker type C60N 2x4A – curve D	24583	MERLIN GERIN	2	
	Fault auxiliary contact for C60N	26927	MERLIN GERIN	2	
Q24V	Circuit breaker type C60N 1x10A – curve C	24175	MERLIN GERIN	1	
	Fault auxiliary contact for C60N	26927	MERLIN GERIN	1	
KPS01/02	Relay type RS30–NV – 1RT – 24V=	944401	WEIDMULLER	2	
PS01–PS02	Power supply 230V~/24V= – 240W	ABL–7RE2410	TELEMECANIQUE	2	
Diode	Power diode type SKN26/04 – 20A	113 0376	RS COMPOSANTS	2	
PTB/LTB/MTB/STB	Terminals 4mm2	39061	LEGRAND	–	

câblage électrique asm

AIR LIQUIDE INGENIERIE

JOB Number 50–2852
Designation ZAPORO

DOCUMENT NUMBER 841–1041

BOOSTER AIR SURPRESSOR

MODIN M1030
DCS CABINET Y1041
Equipment list

index	0					PAGE
date	13–05–05					97/99
name	S.P.					
sign	F.M.					

A1/1312 – P7058–97.DWG – © A.S.M. – ATELIER SEINE ET MARNE – BP25–77241 CESSON CEDEX–TEL:(33) 1.64.79.60.40–FAX:(33) 1.60.63.57.49

TAG	DESIGNATION	REFERENCE	FIRM	QTY	REMARKS
X1	Fuse terminal type SAK	39086	LEGRAND	16	
	Glass fuse 6.3A – 5x20 – For fuse terminal	102 63	LEGRAND	16	
Rack ANR01–04	Centum CS3000 – Model ANR10*	*	YOKOGAWA	1	Supply by customer
	Card AAI835 4 channel input/4channel output, isolated channels	AAI835	YOKOGAWA	1	Supply by customer
	Cable MIL 40 Pts	51023537	WAGO	1	Supply by customer
	Interface module 4AI/4AO	4AI/4AO–MIL–R–SW	YOKOGAWA	1	Supply by customer
	Card AAI135 8 channel input, isolated channels	AAI135	YOKOGAWA	3	Supply by customer
	Cable MIL 40 Pts	51023537	WAGO	3	Supply by customer
	Interface module 8AI	8AI–MIL–R–SW	YOKOGAWA	3	Supply by customer
	Card AAR145 16 channel RTD, isolated channels	AAR145	YOKOGAWA	2	Supply by customer
	Cable MIL 50 Pts	51023538	WAGO	2	Supply by customer
	Interface module 16RTD	16RTD–KS–R	YOKOGAWA	2	Supply by customer
	Card ADV151 32 digital input	ADV151	YOKOGAWA	1	Supply by customer
	Cable MIL 50 Pts	51023538	WAGO	1	Supply by customer
	Interface module 32DI	32DI–MIL–R	YOKOGAWA	1	Supply by customer
	Card ADV551 32 digital output	ADV551	YOKOGAWA	1	Supply by customer
	Cable MIL 50 Pts	51023538	WAGO	1	Supply by customer
	Interface module 32DO	32DO–MIL–R	YOKOGAWA	1	Supply by customer

câblage électrique asm

AIR LIQUIDE INGENIERIE

JOB Number 50–2852
Designation ZAPORO

DOCUMENT NUMBER 841–1041

BOOSTER AIR SURPRESSOR

MODIN M1030
DCS CABINET Y1041
Equipment list

index	0					PAGE
date	13–05–05					99/99
name	S.P.					
sign	F.M.					

A1/1312 – P7058–99.DWG – © A.S.M. – ATELIER SEINE ET MARNE – BP25–77241 CESSON CEDEX–TEL:(33) 1.64.79.60.40–FAX:(33) 1.60.63.57.49